

MFC05/DS004/IDI01


DSO ADDRESS: 22


MFC LOC: C-4-11,12
24 VDC SUPPLY POWER


02-06-10 MG SHEET 22/63


D. ORLANDO 20 AUG 90		PP-5248E-03-2911-01/ 4017	
CABINET #6547-J-08C		LOCAL EQUIPMENT ROOM NO. 2	
Bailey Controls Company		CUSTOMER: QATAR GENERAL PETROLEUM CORPORATION PLANT: NORTH FIELD DEVELOPMENT PROJECT CONTRACTING ENG.: TECHNIP B.C.CO. JOB NO.: 342119CUST. ORDER NO.: 5248E	
FILE NO.: 2061022I			


CADEWS

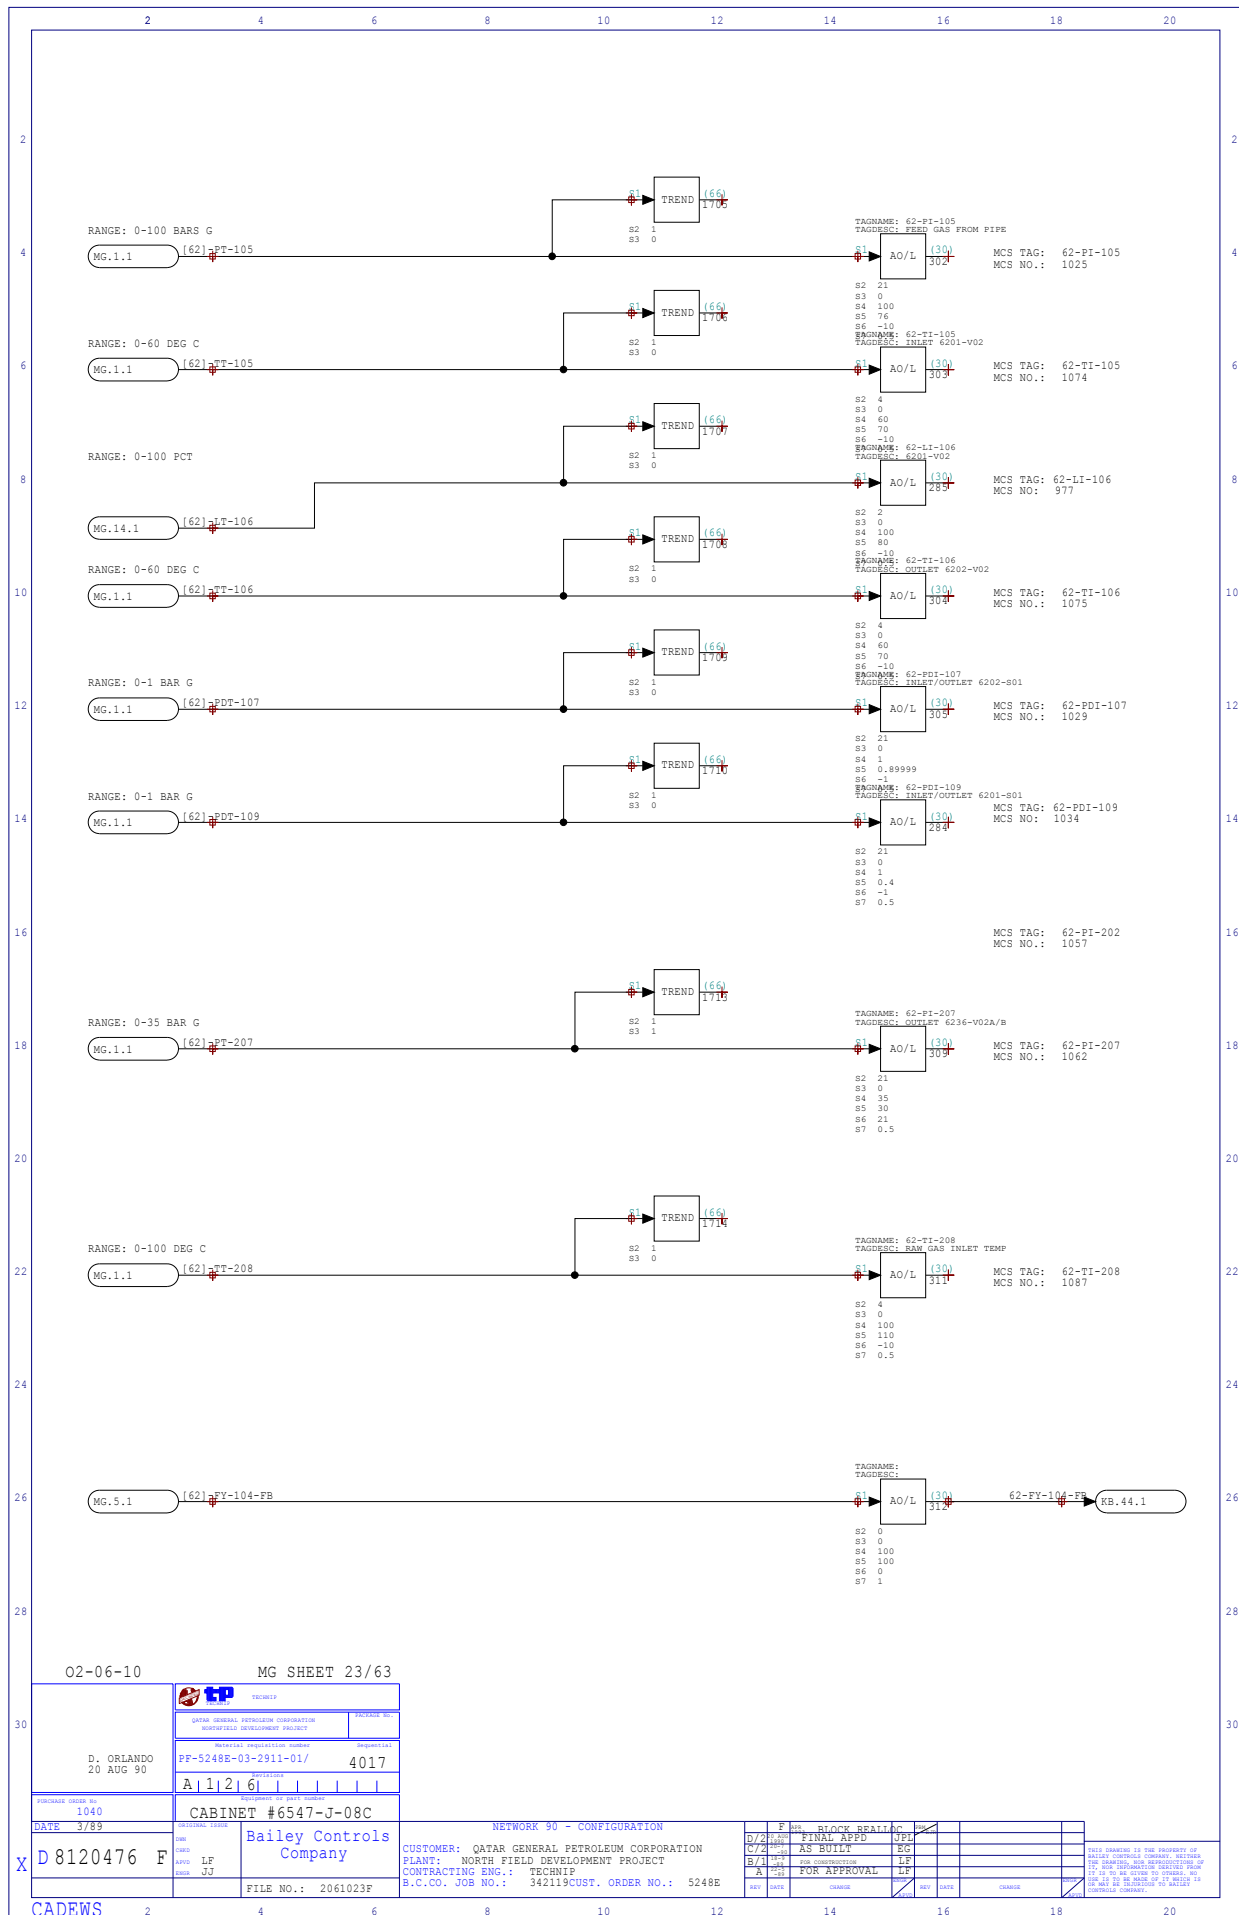


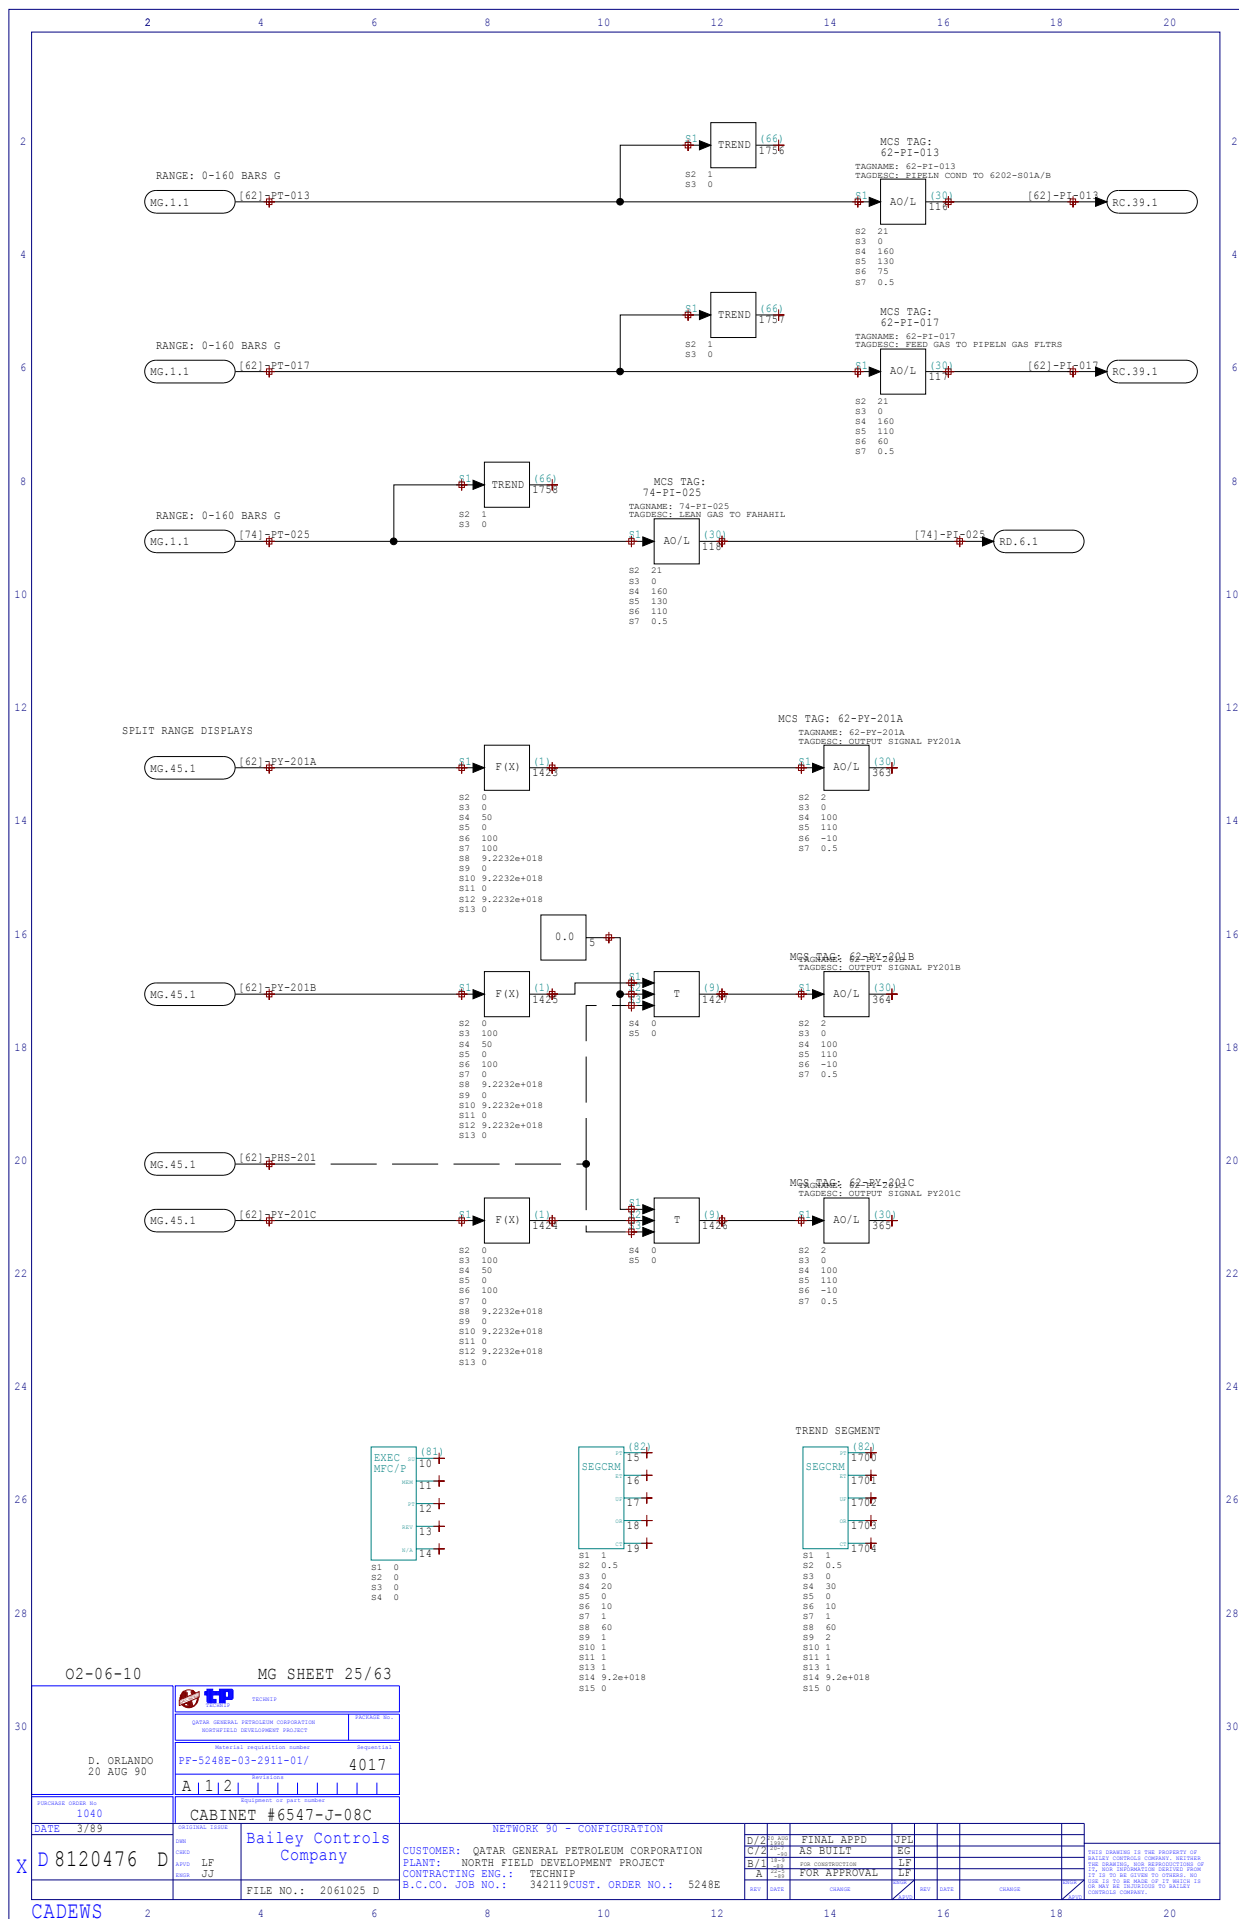


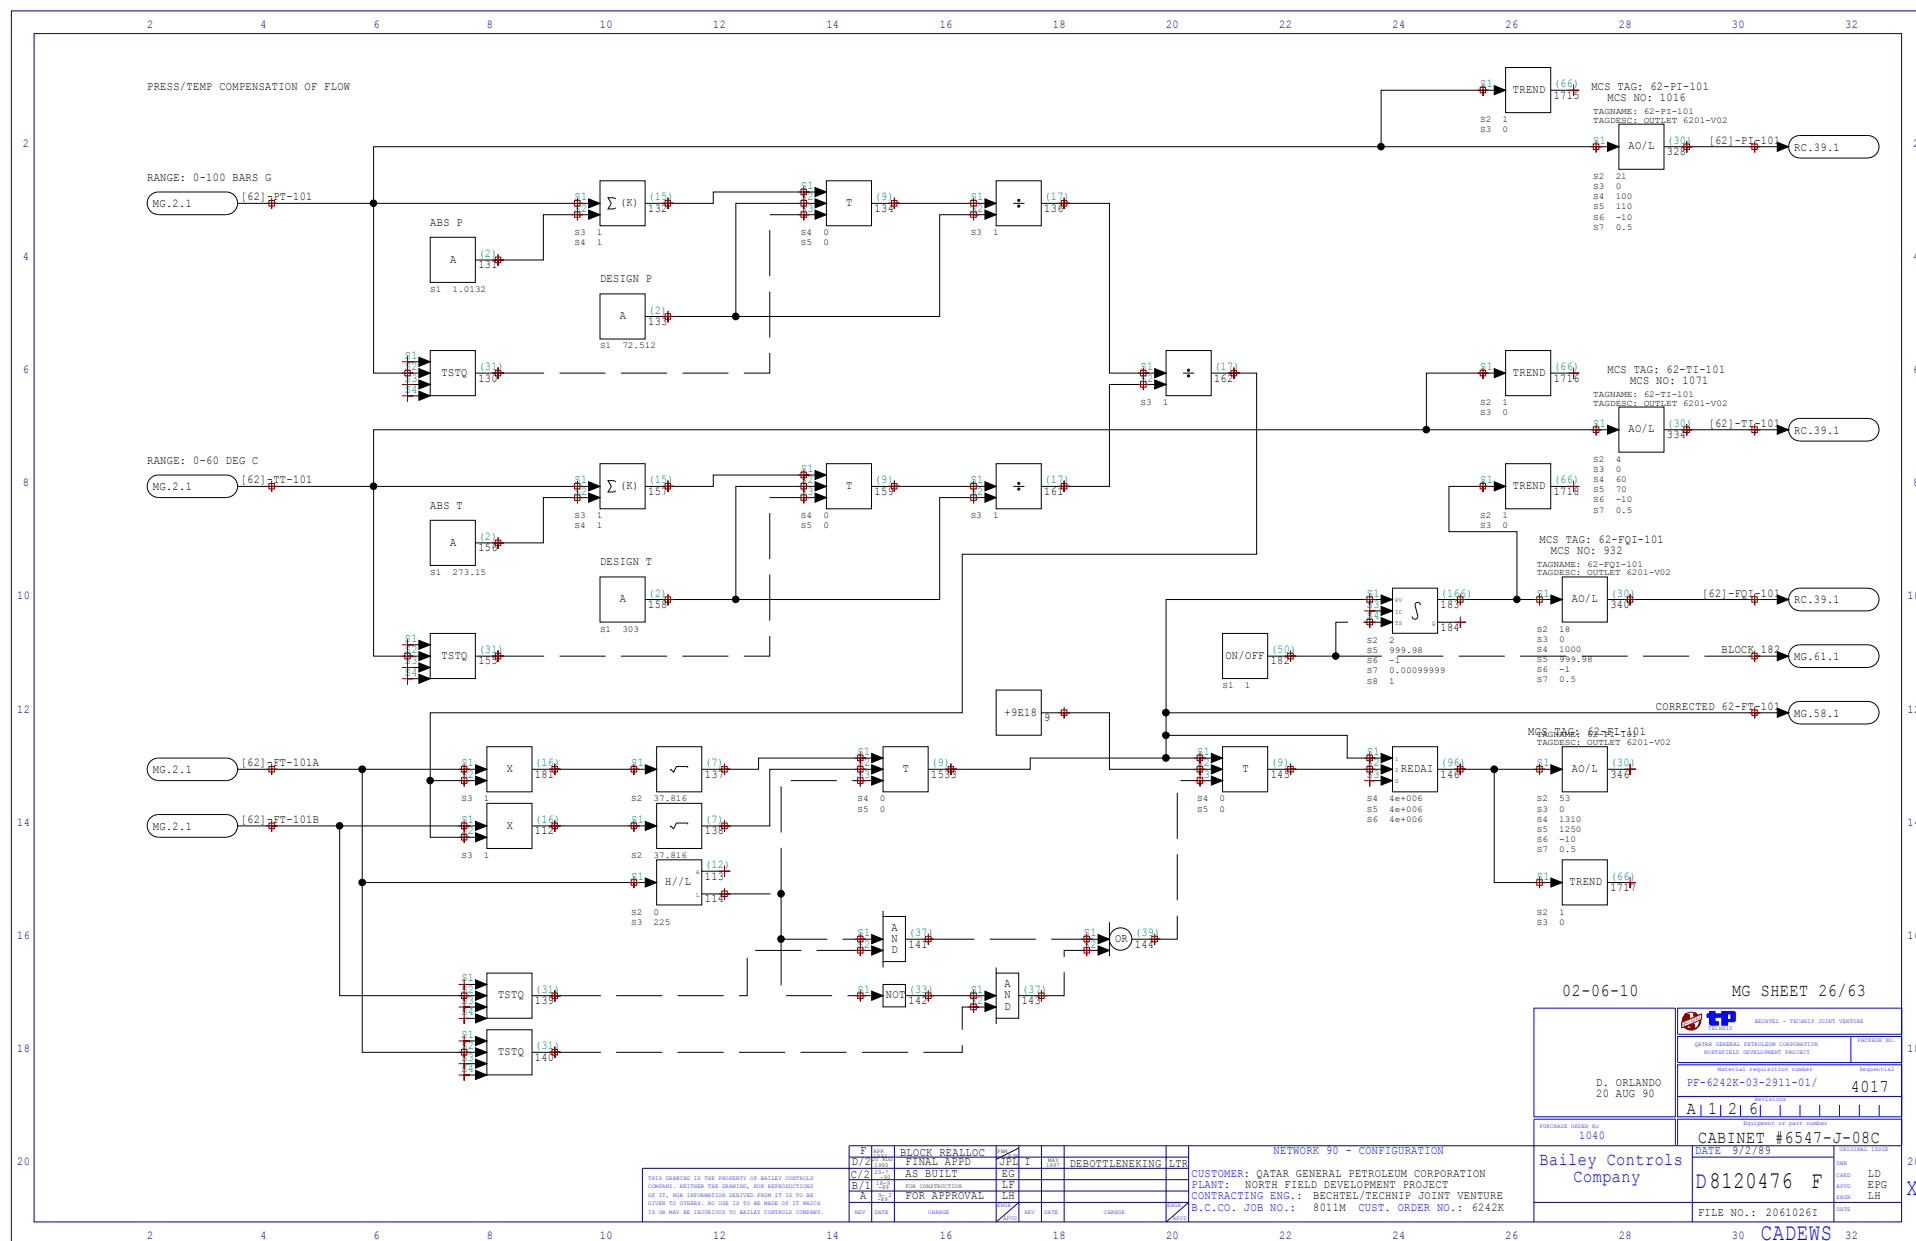


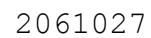


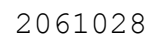


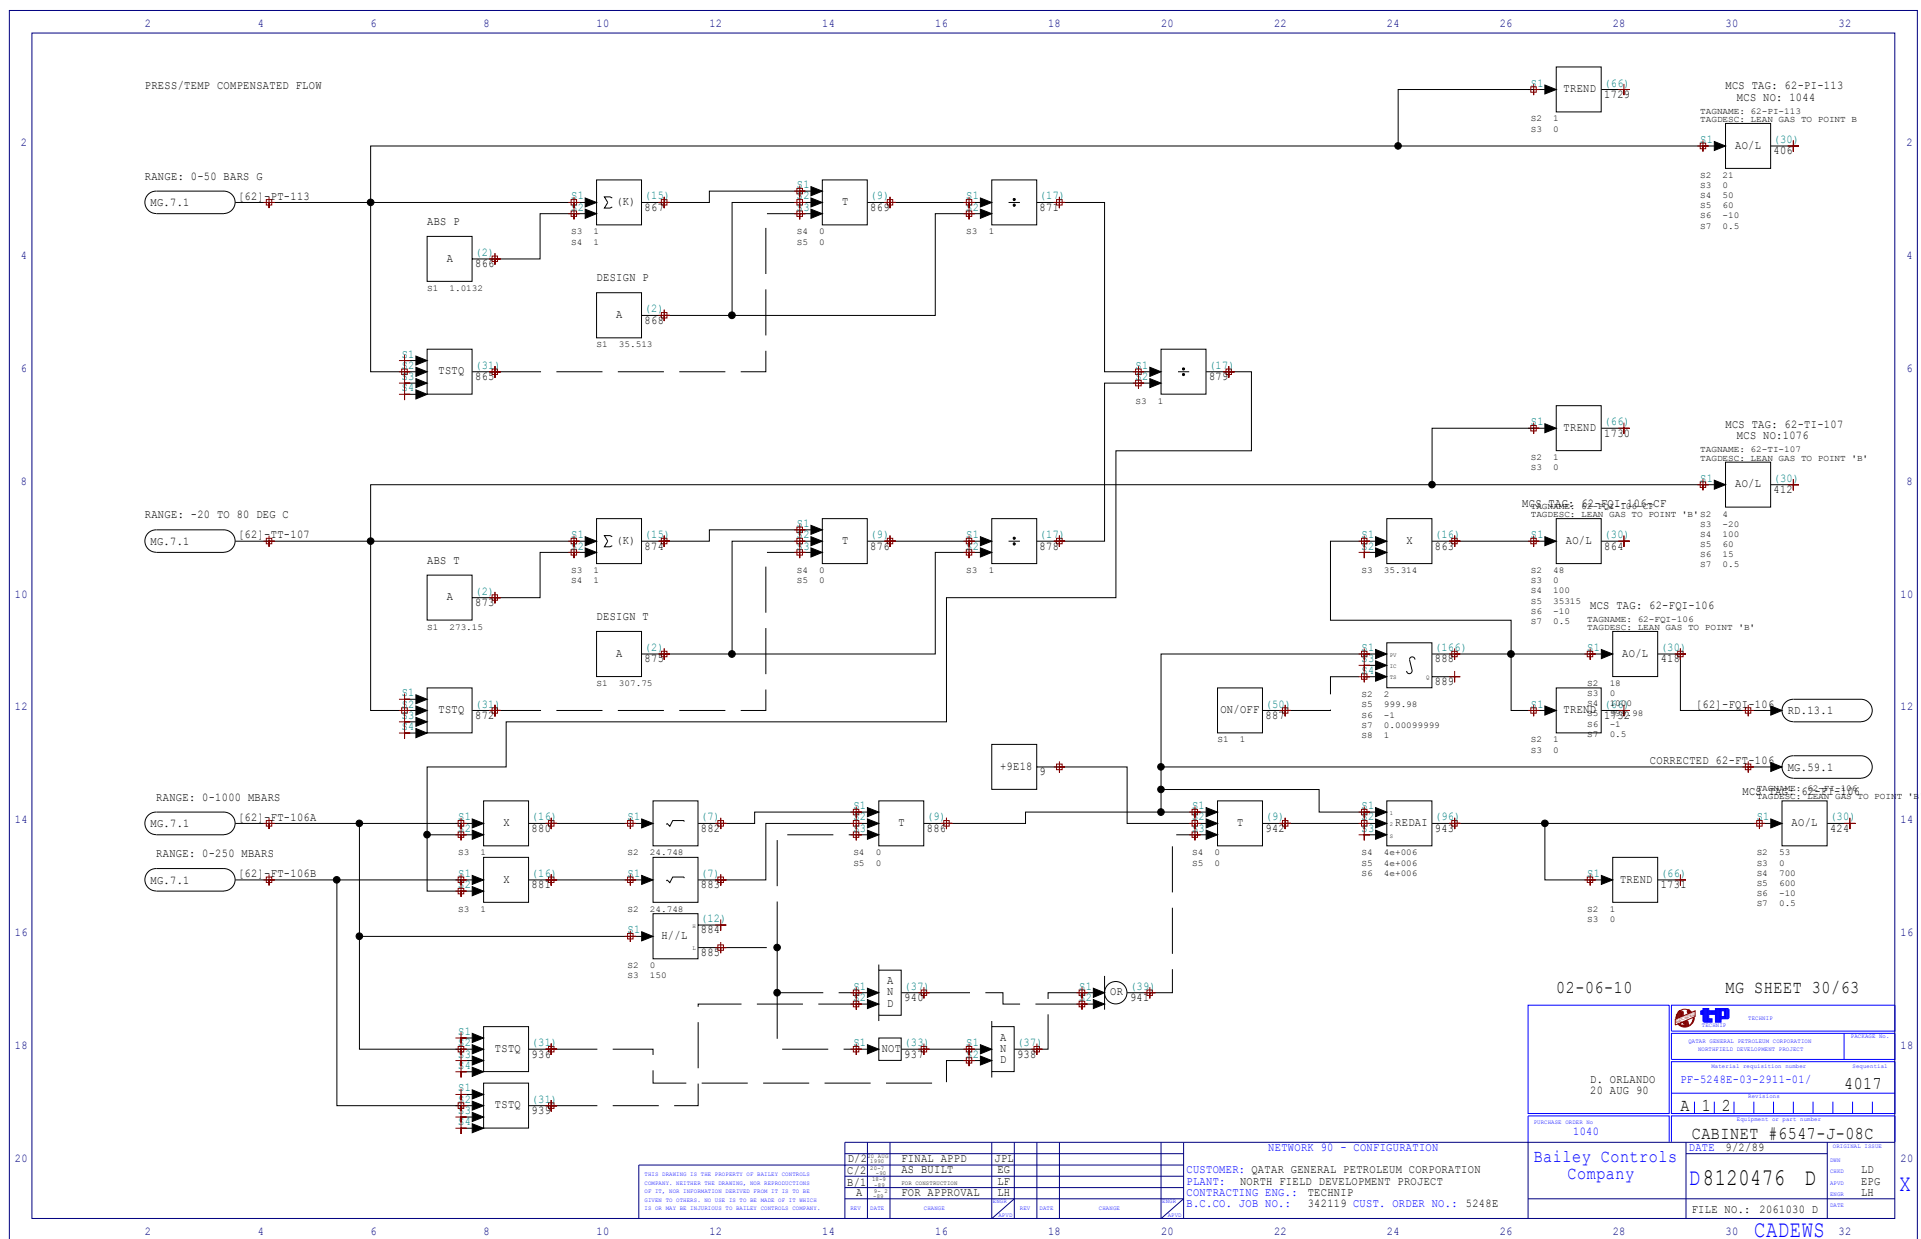


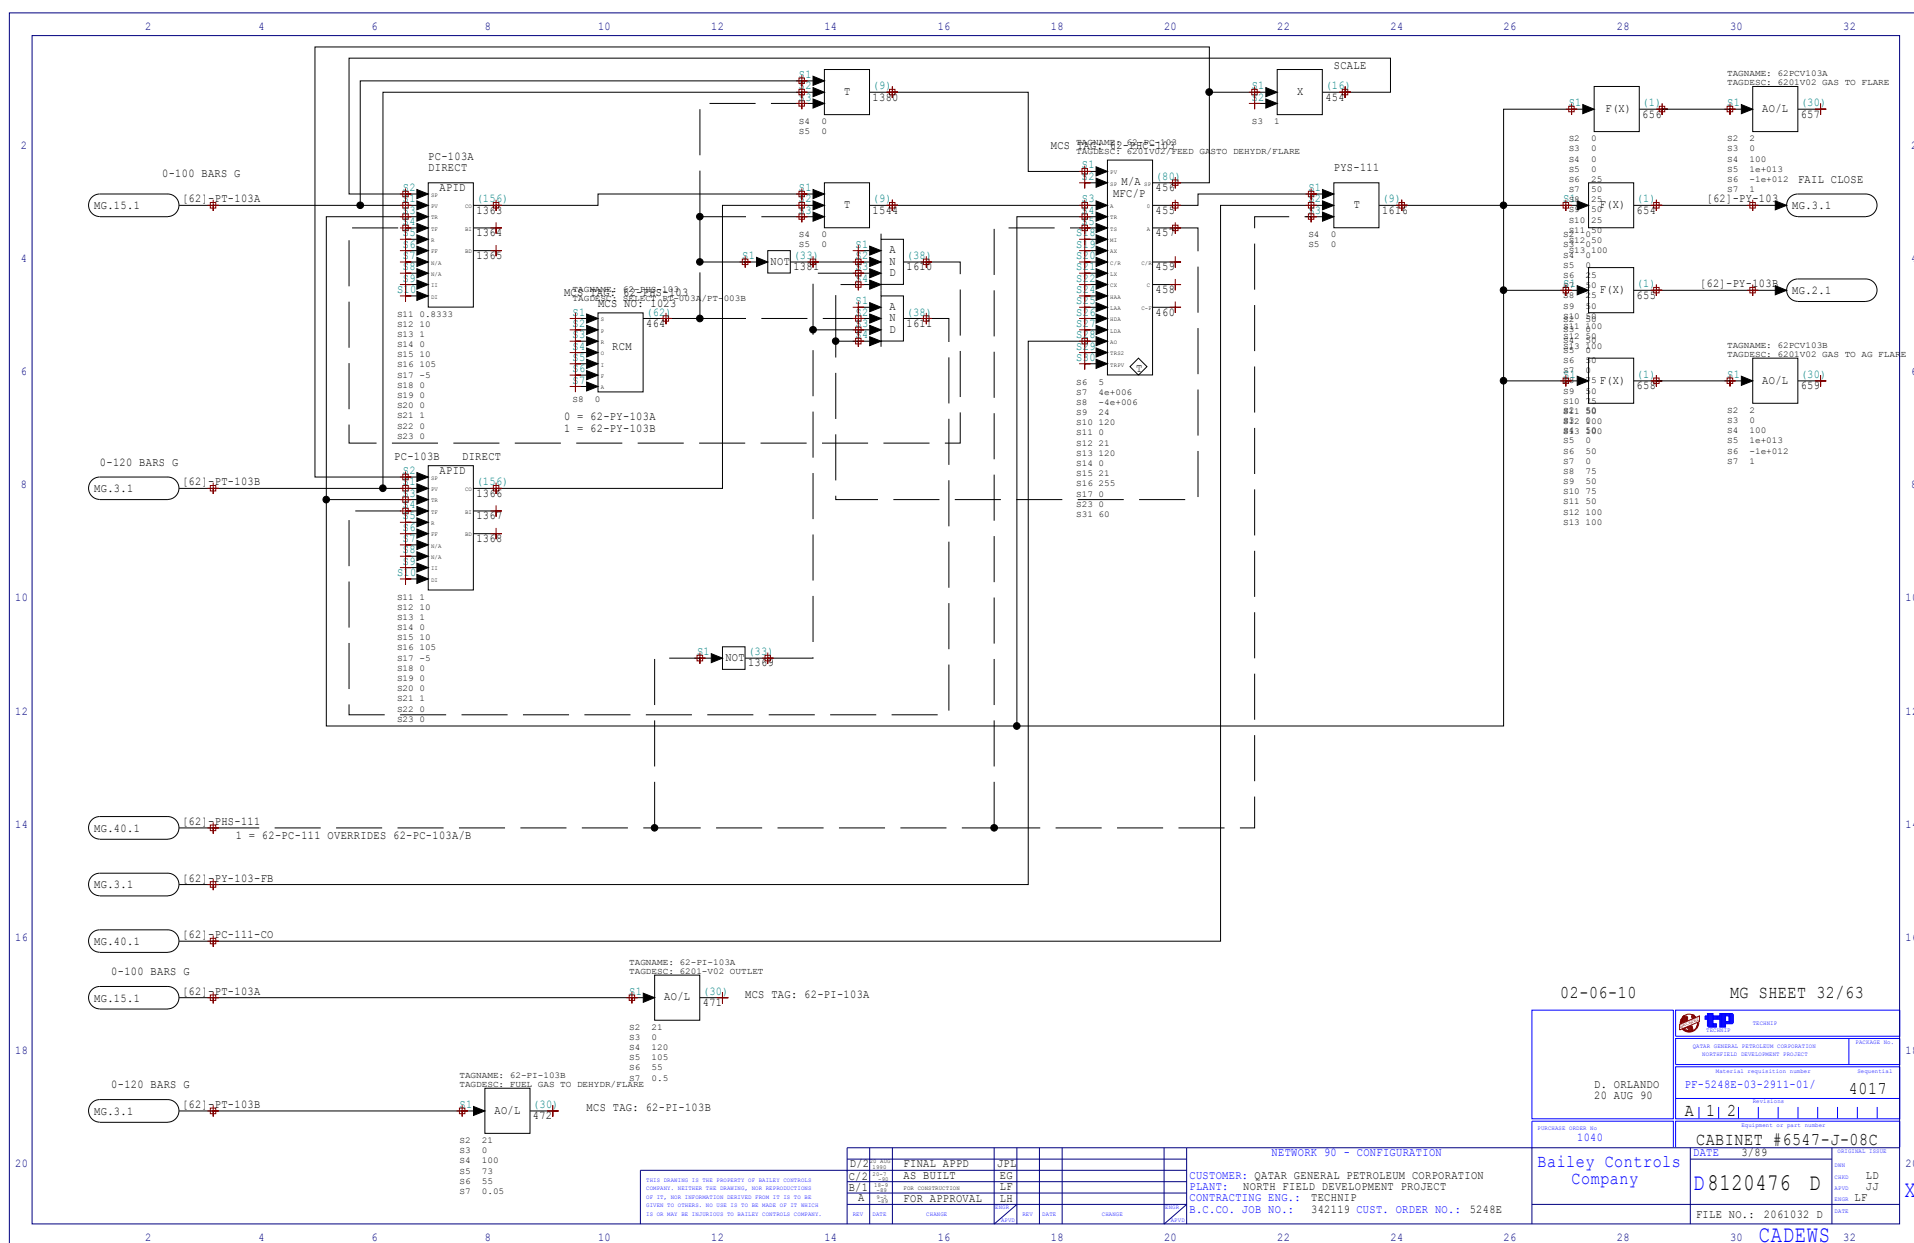

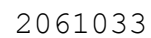

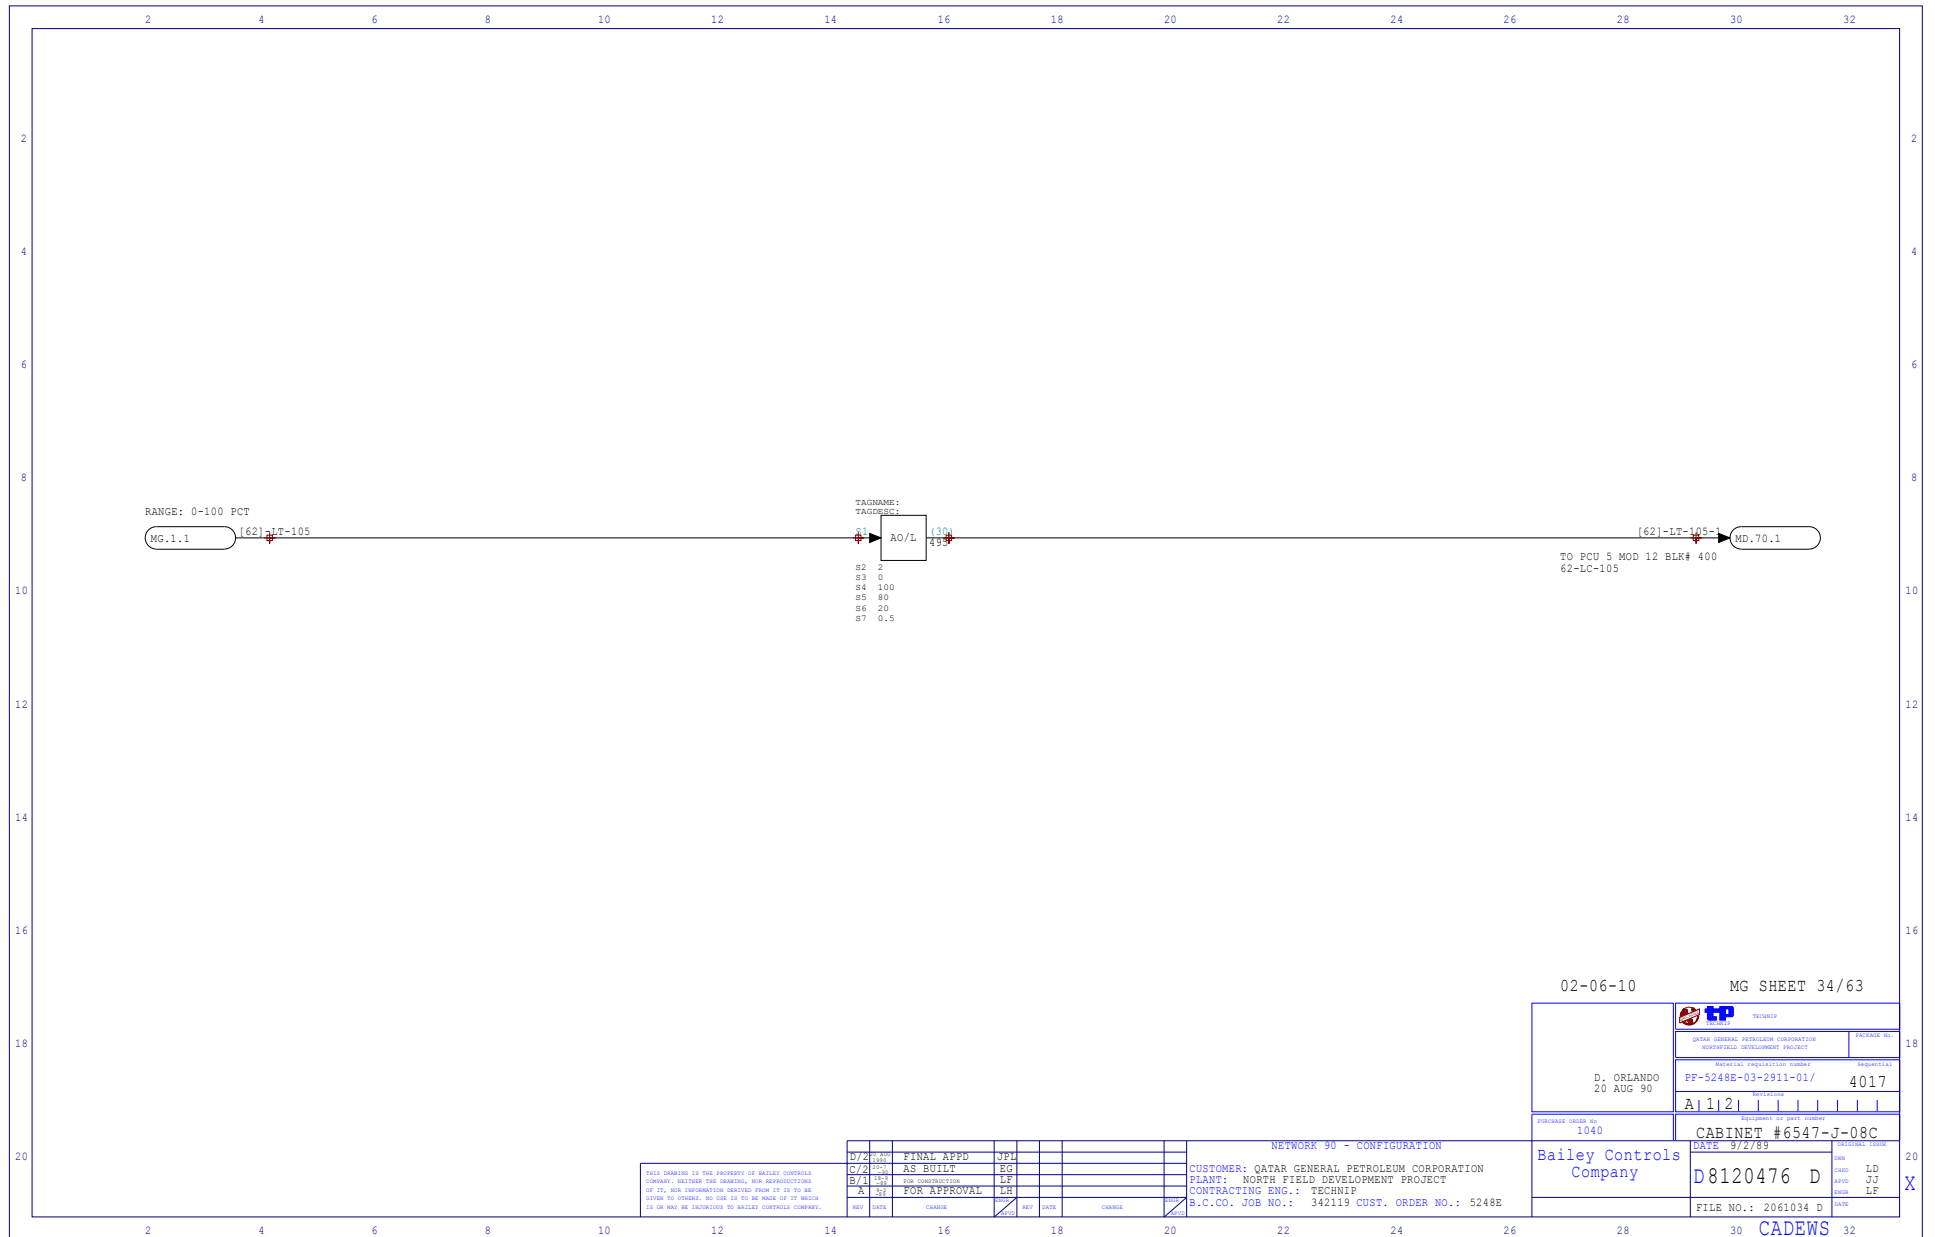

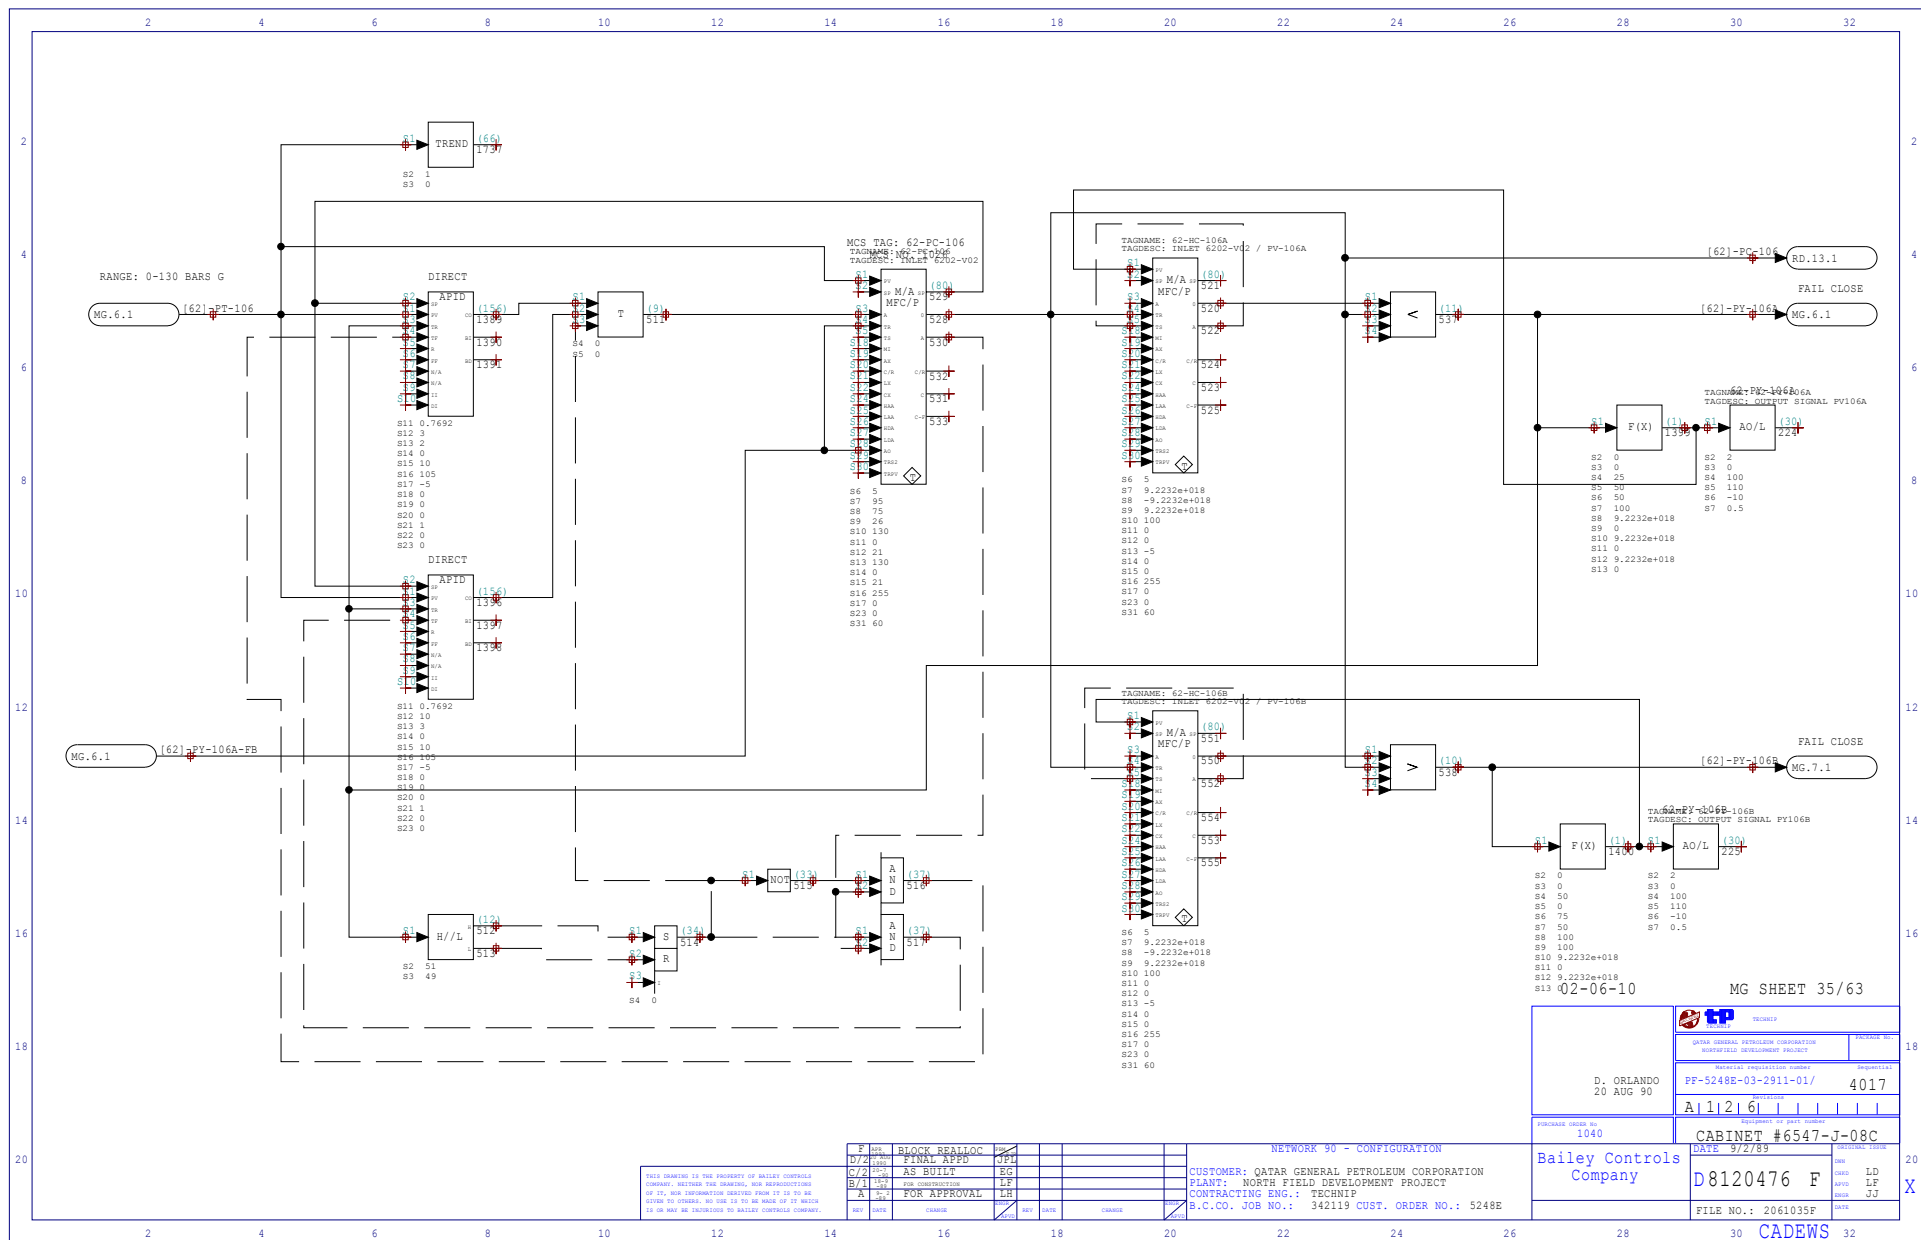

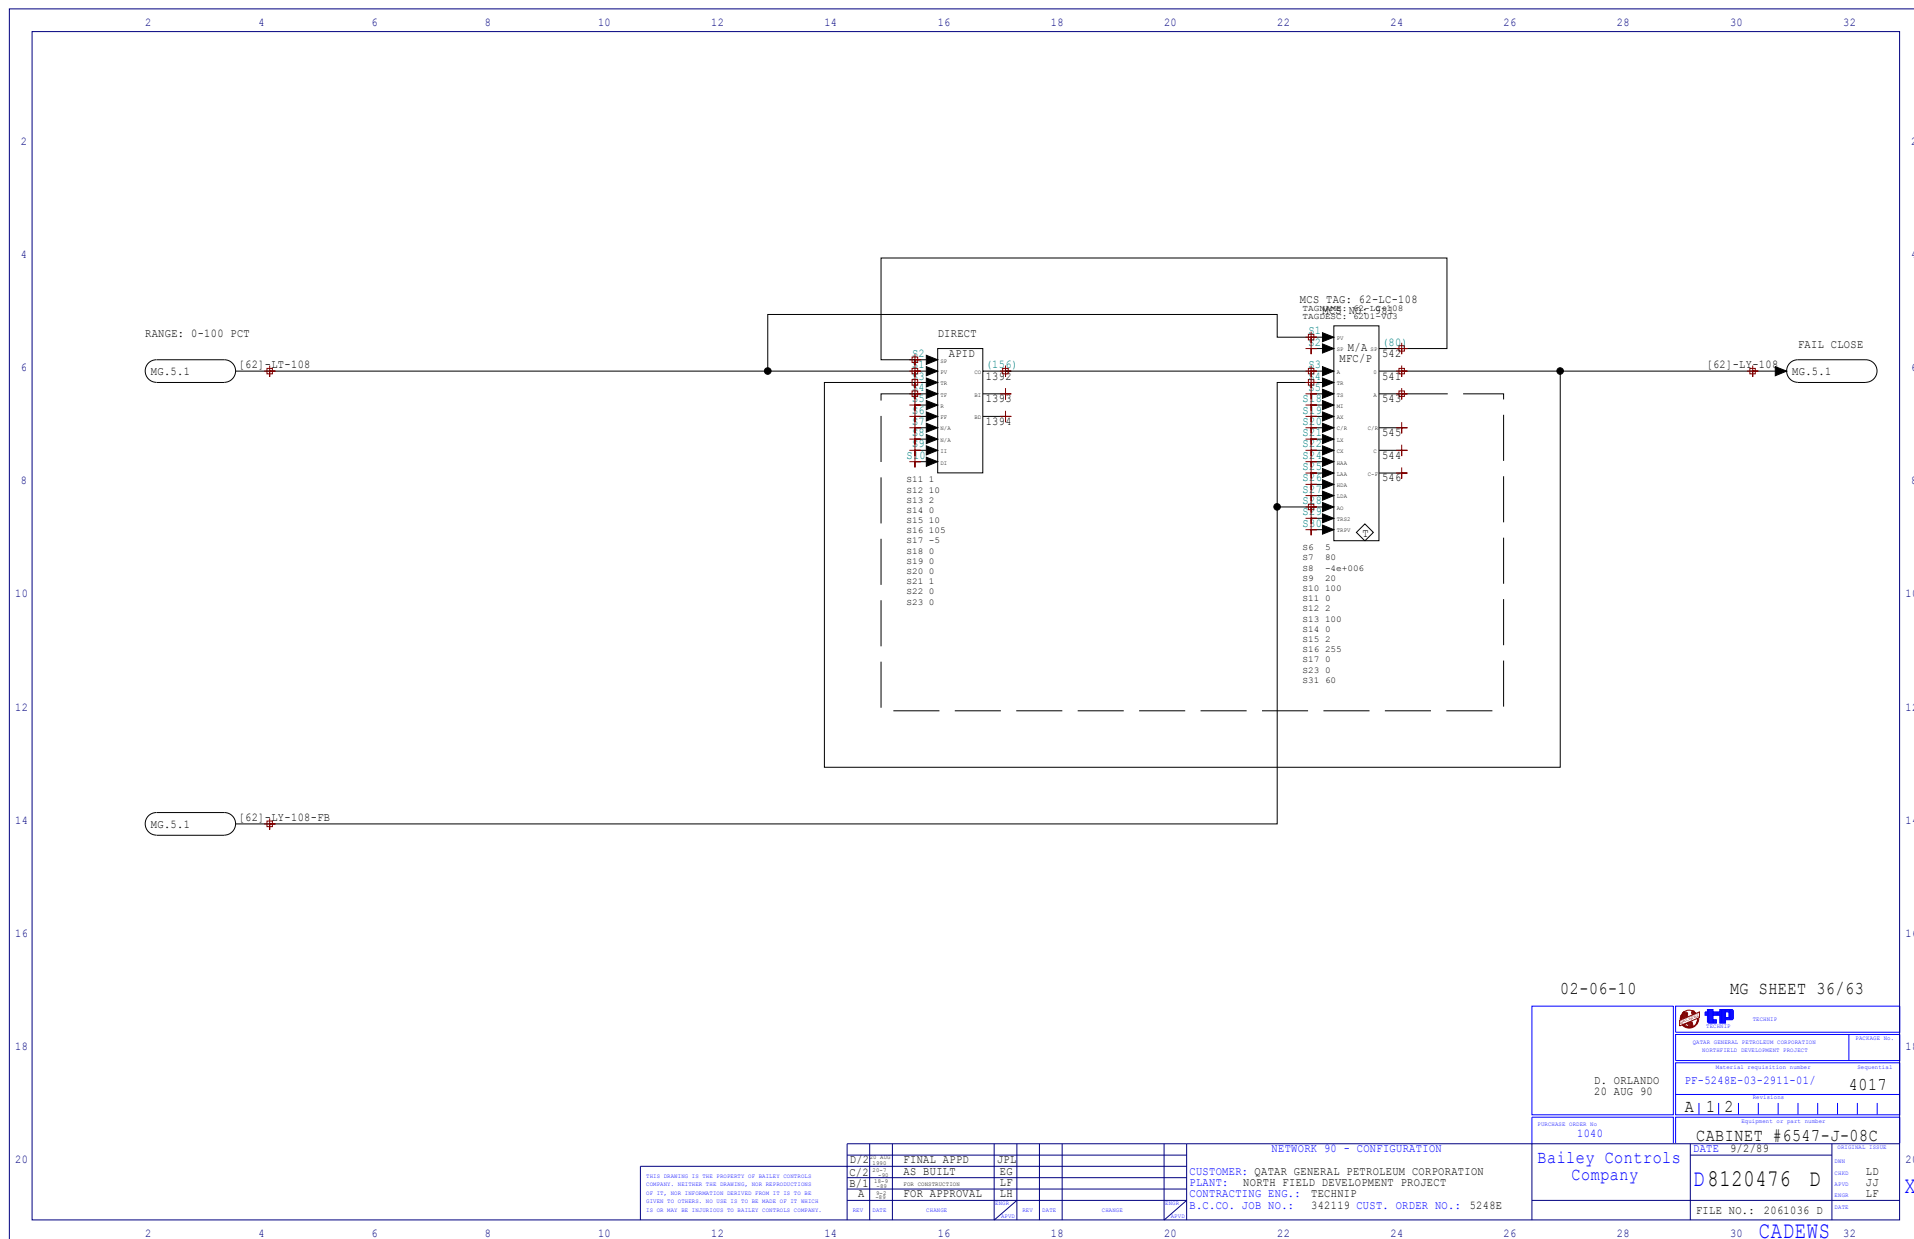


02-06-10 MG SHEET 36/63


D. ORLANDO 20 AUG 90	TECHNIP	
	QATAR GENERAL PETROLEUM CORPORATION NORTHFIELD DEVELOPMENT PROJECT	
	RECEIVED PROJECTED NUMBER PF-5248E-03-2911-01/ 4017	
	DATE 9/2/89 CABINET #6547-J-08C	
PURCHASE ORDER NO. 1040	BAILEY CONTROLS Company	
DATE 9/2/89 D8120476 D		LD JJ LF
FILE NO.: 2061036 D		CADEWS


NETWORK 90 - CONFIGURATION									
U/2	1000	FINAL APPD	JPL						
C/2	1000	AS BUILT	EG						
B/1	1000	FOR CONSTRUCTION	LF						
A	50	FOR APPROVAL	LH						
REV	DATE	CHANGE	REV	DATE	CHANGE				


THIS DRAWING IS THE PROPERTY OF BAILEY CONTROLS COMPANY. WITHOUT THE WRITING, NO REPRODUCTION OF IT, AND INFORMATION DERIVED FROM IT IS TO BE RETURNED TO ORLANDO. NO USE IS TO BE MADE OF IT BEYOND ITS OR MAY BE INTRODUCED TO BAILEY CONTROLS COMPANY.


CUSTOMER: QATAR GENERAL PETROLEUM CORPORATION
 PLANT: NORTH FIELD DEVELOPMENT PROJECT
 CONTRACTING ENG.: TECHNIP
 B.C.CO. JOB NO.: 342119 CUST. ORDER NO.: 5248E

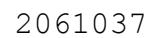


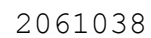


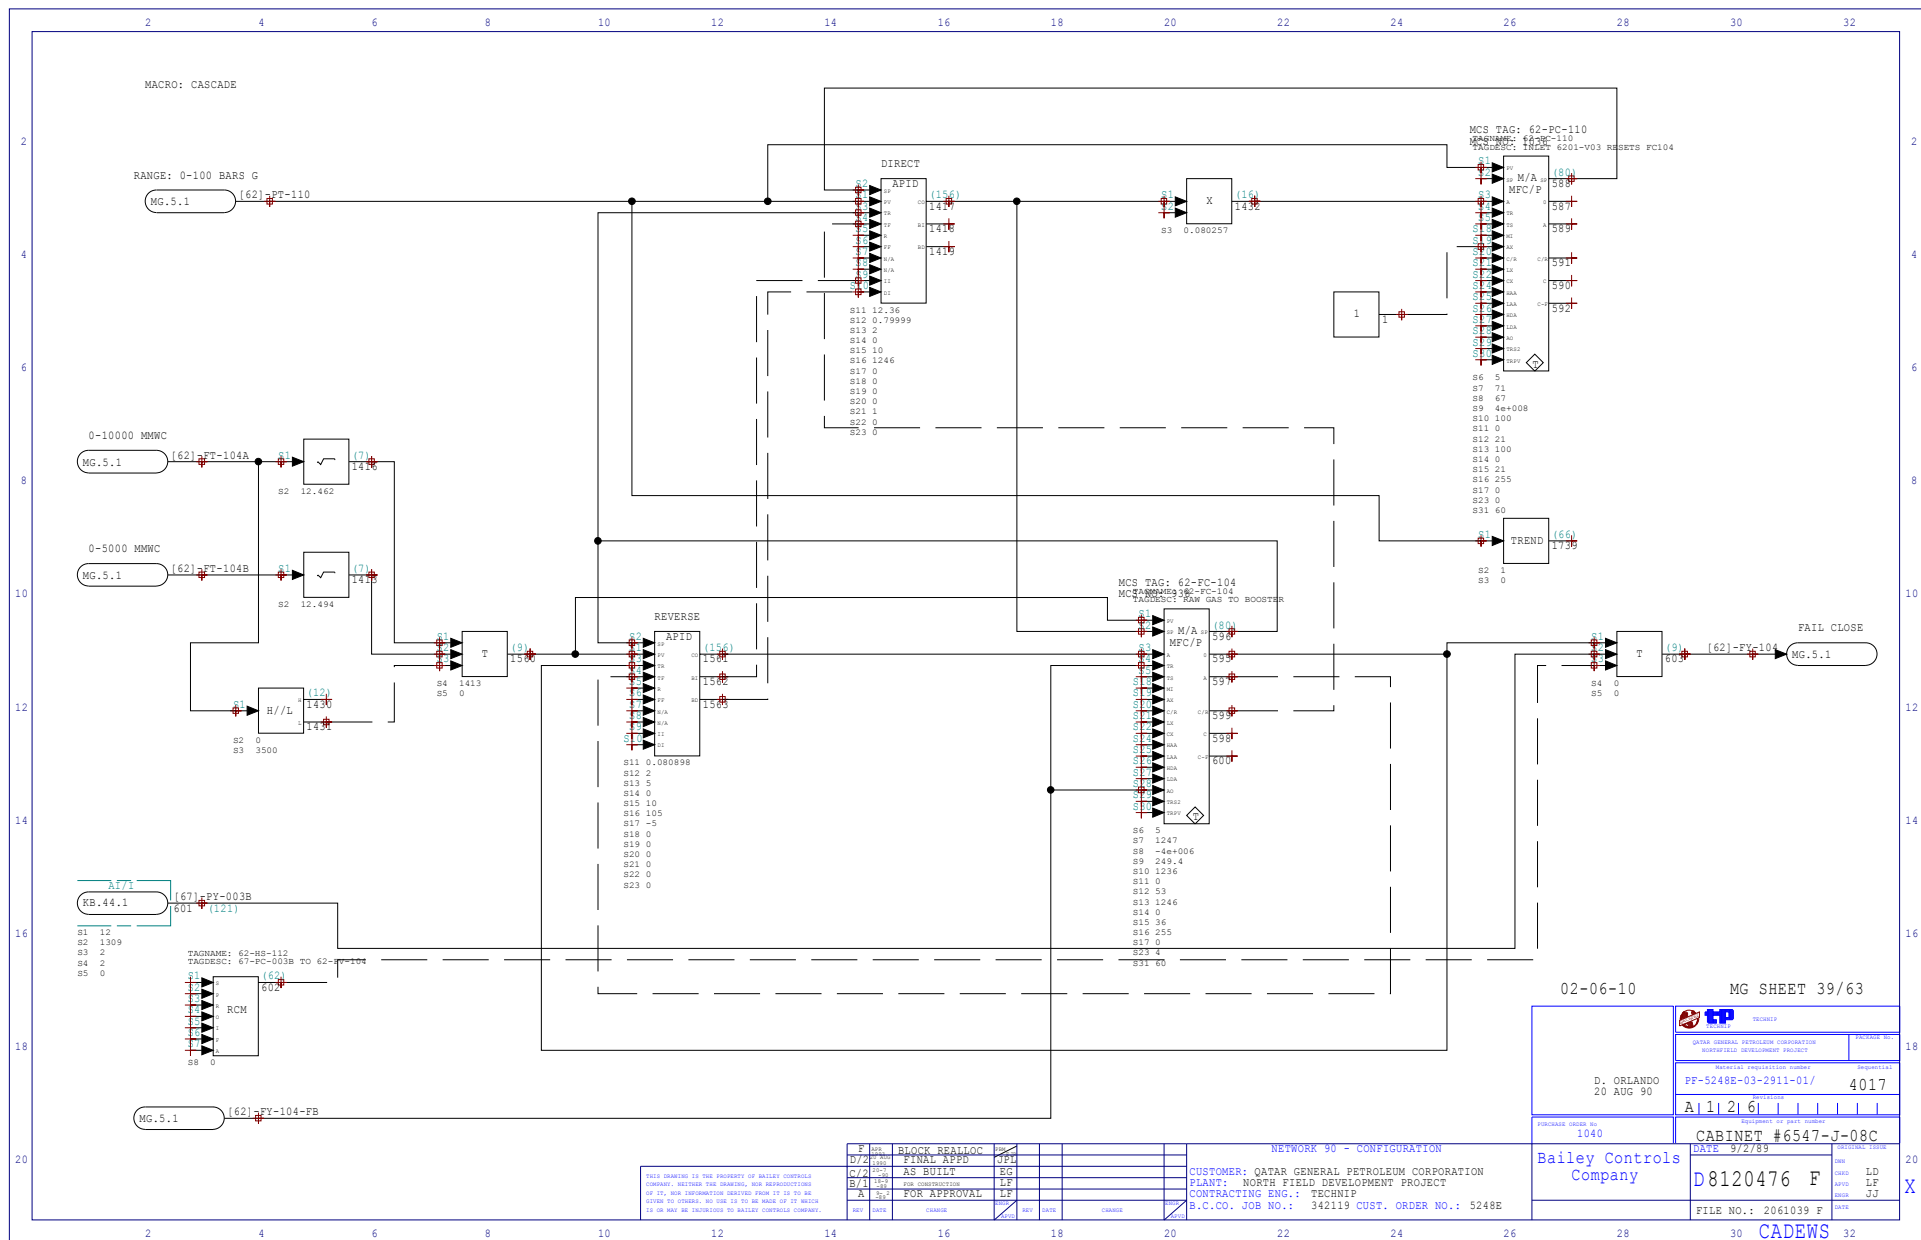


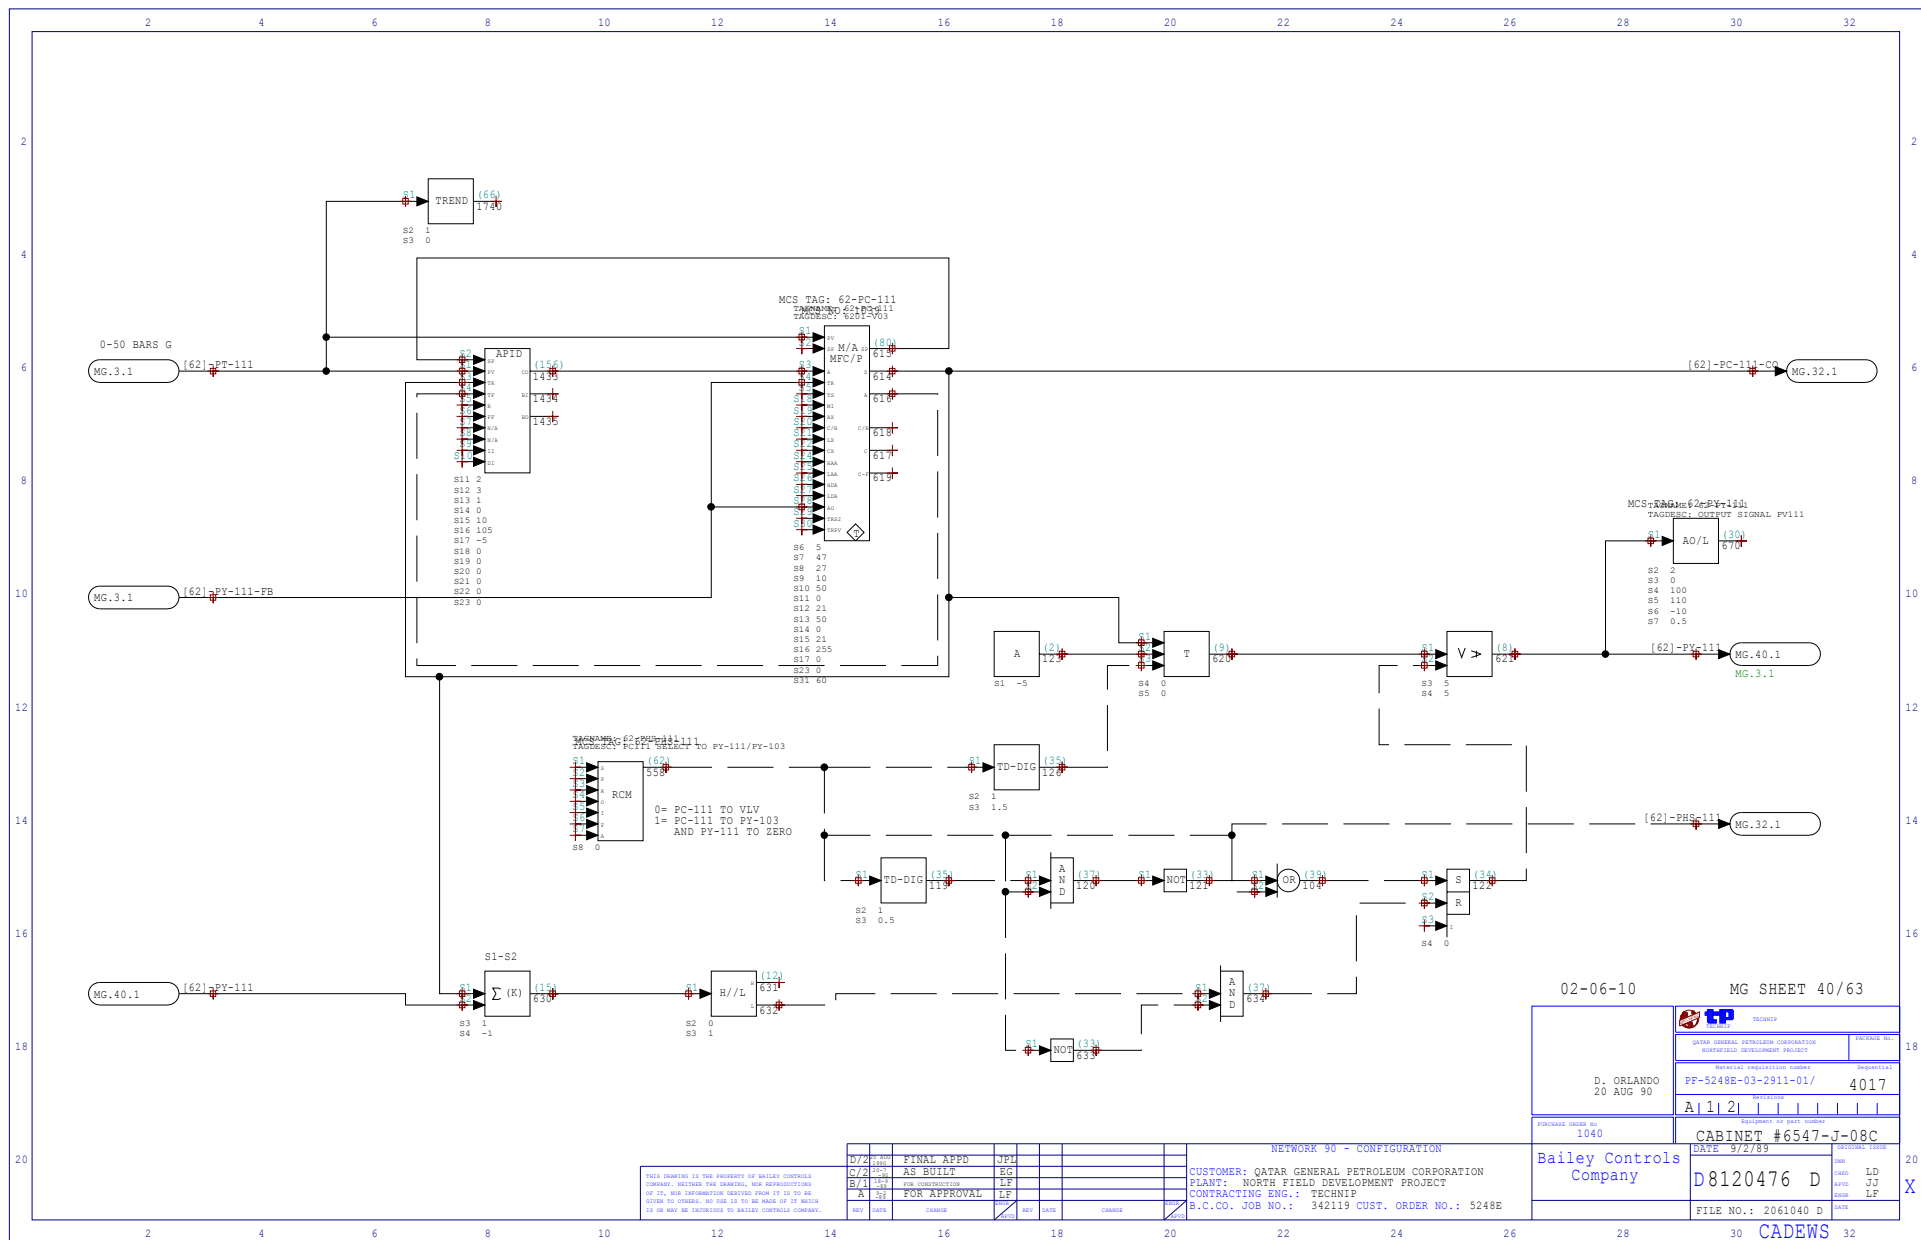


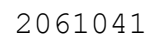


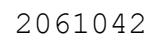


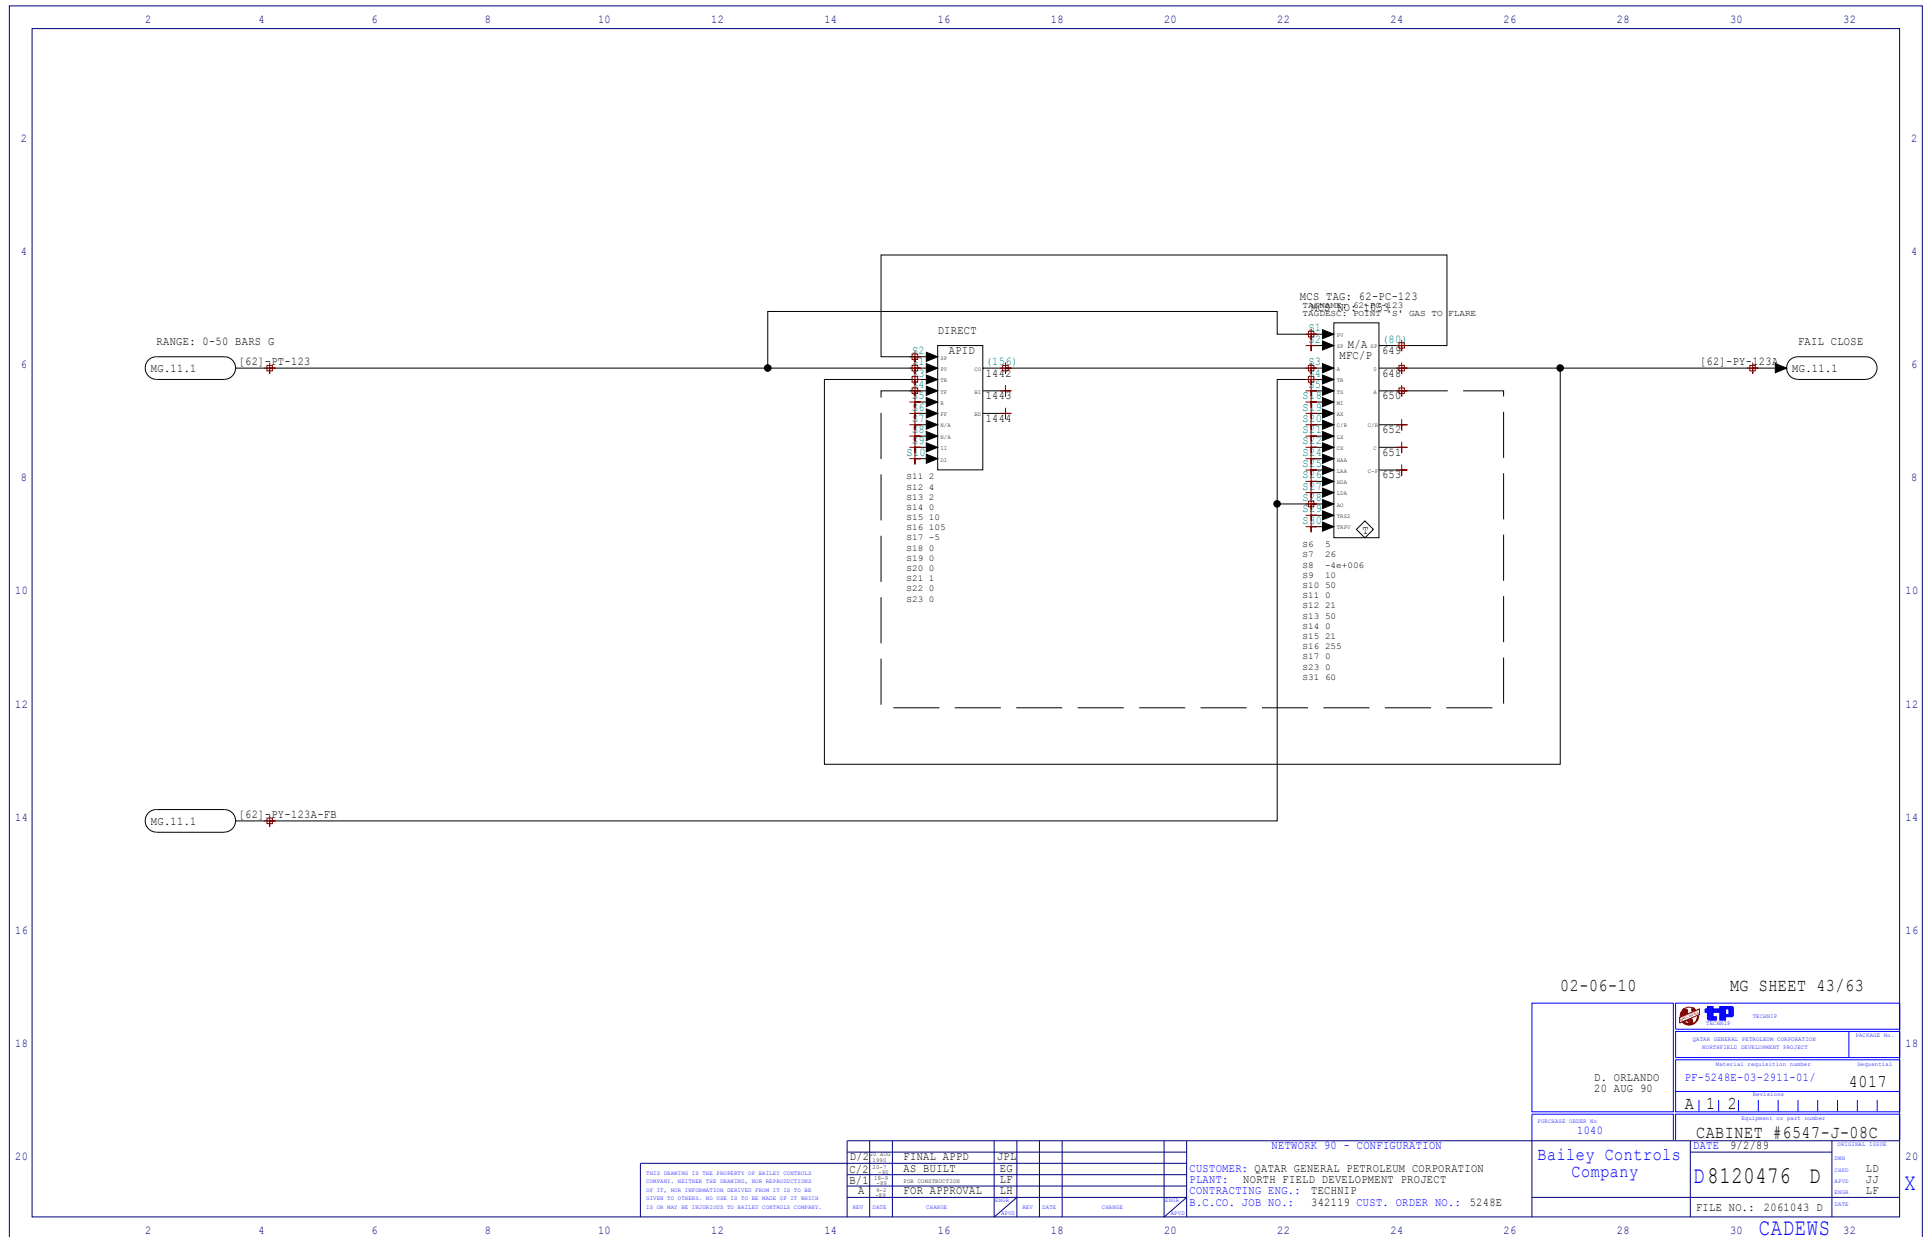


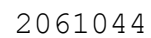


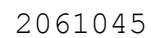


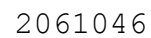


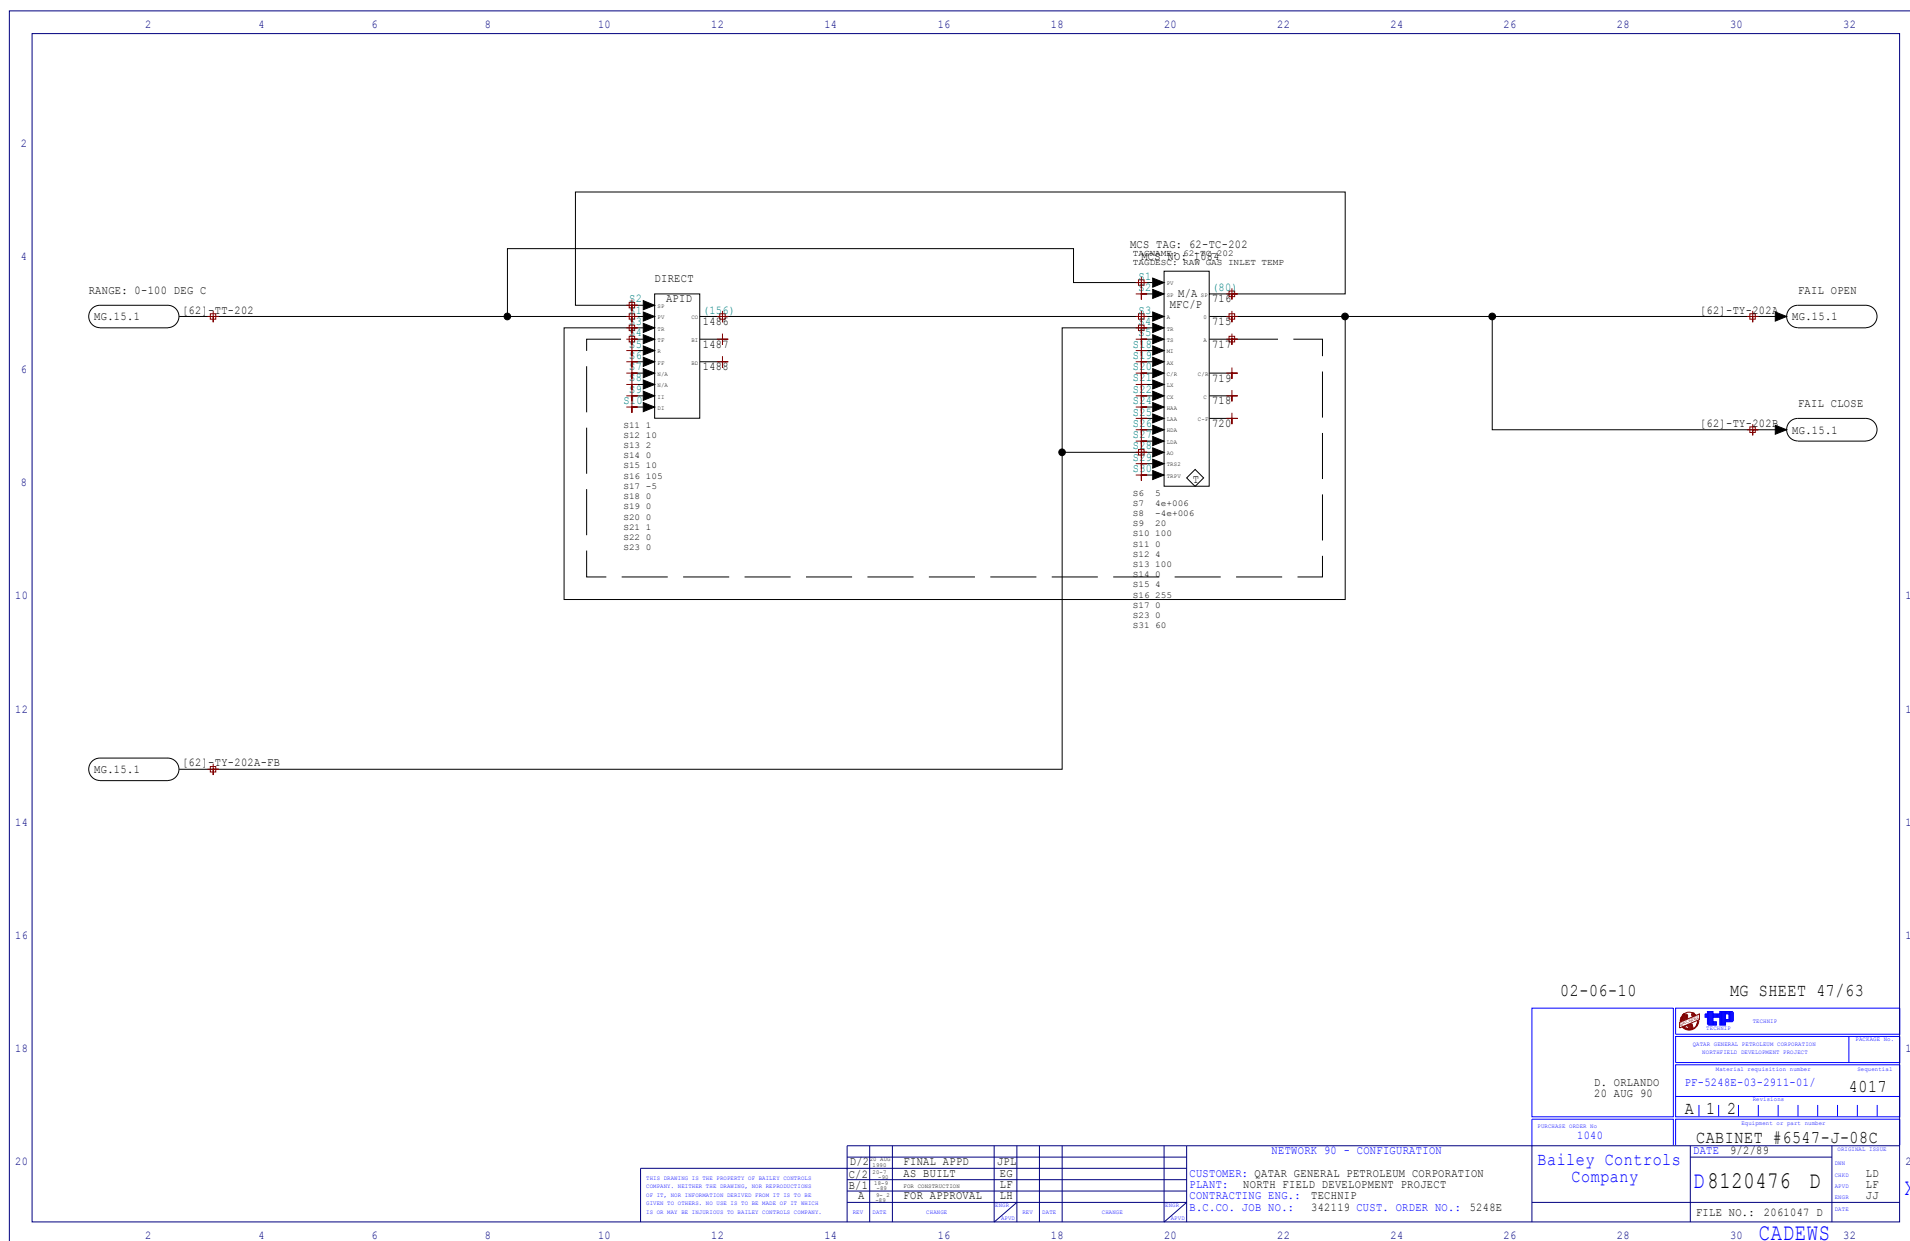


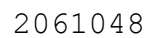


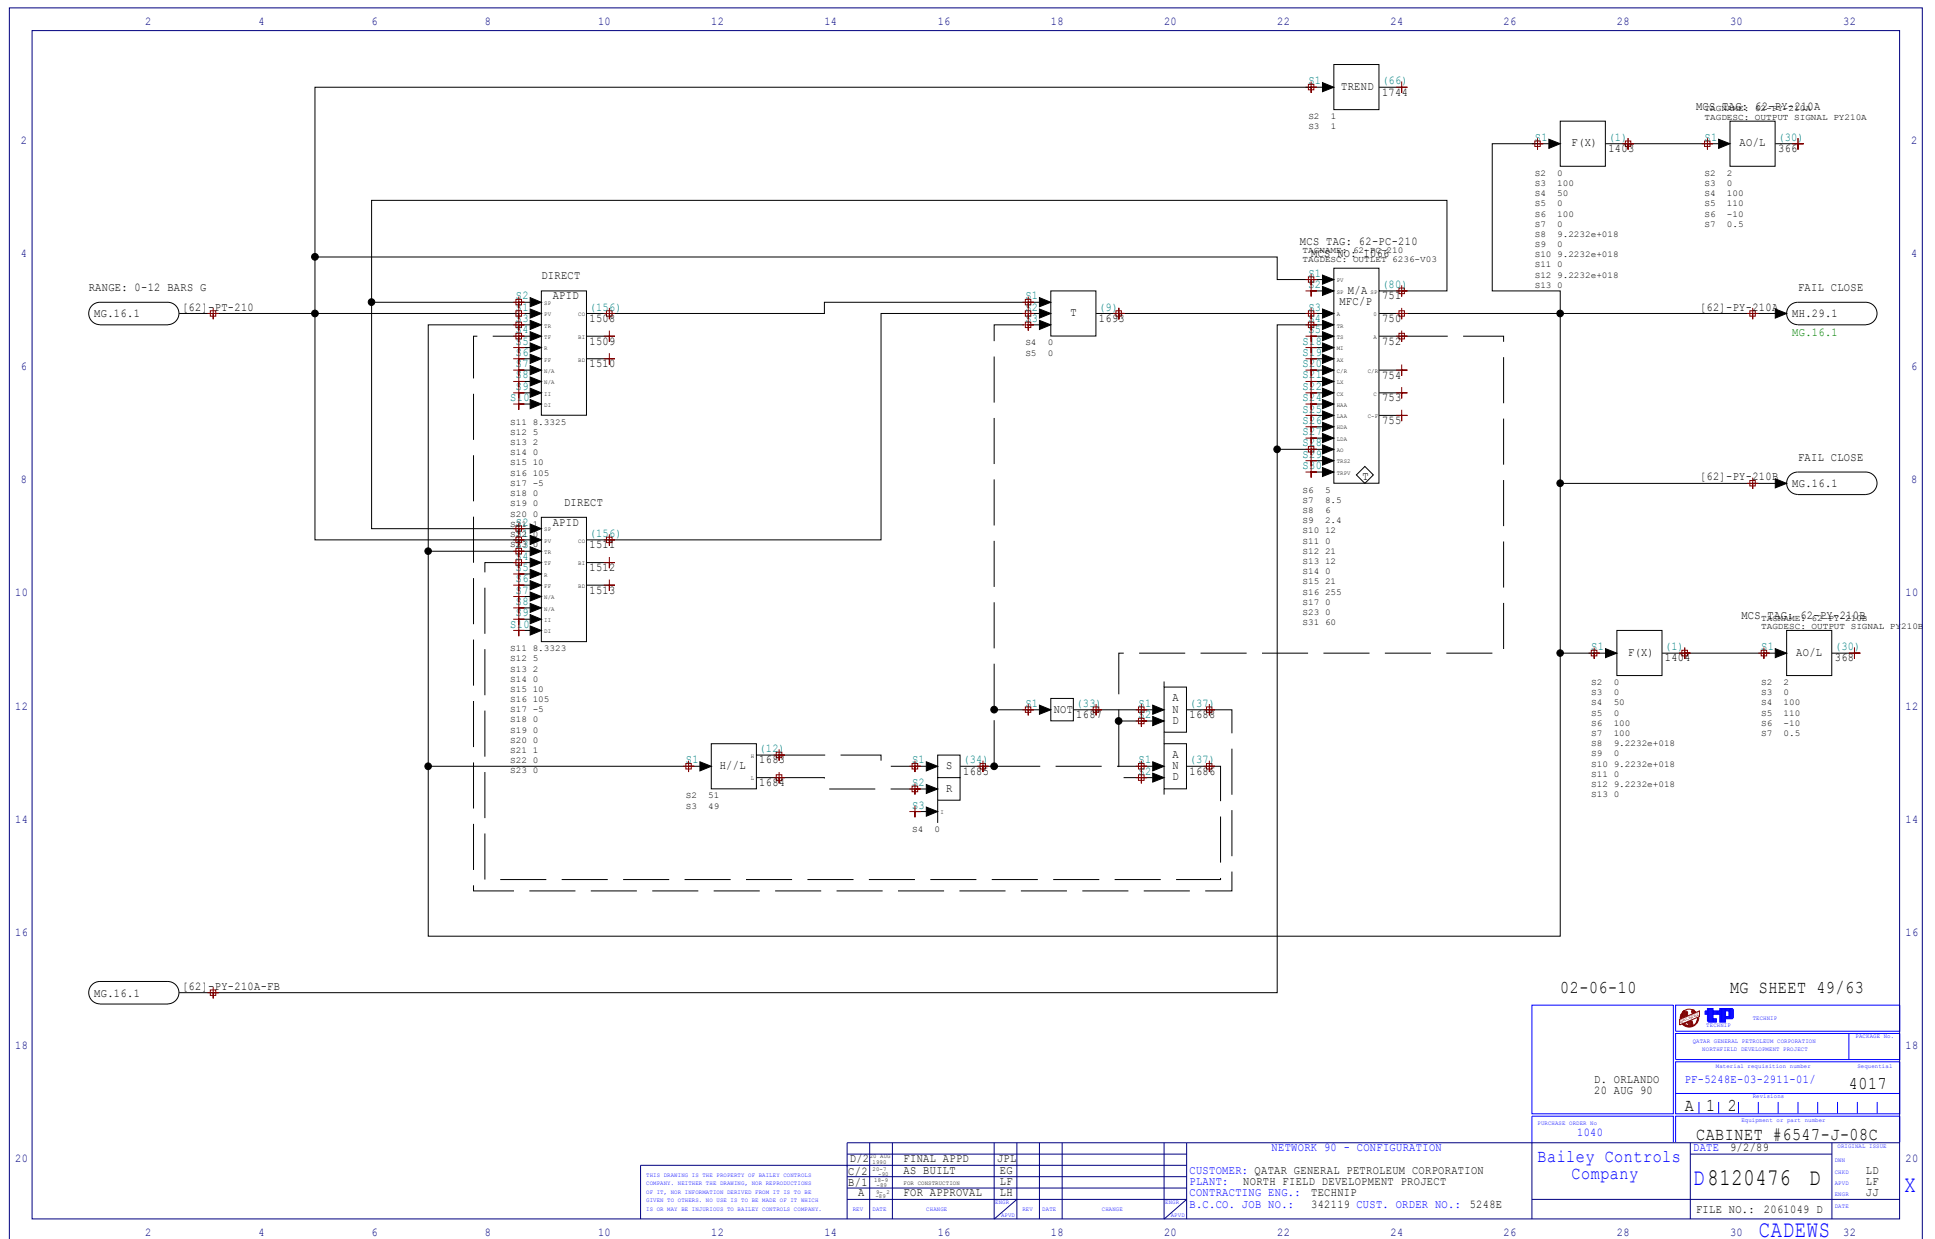


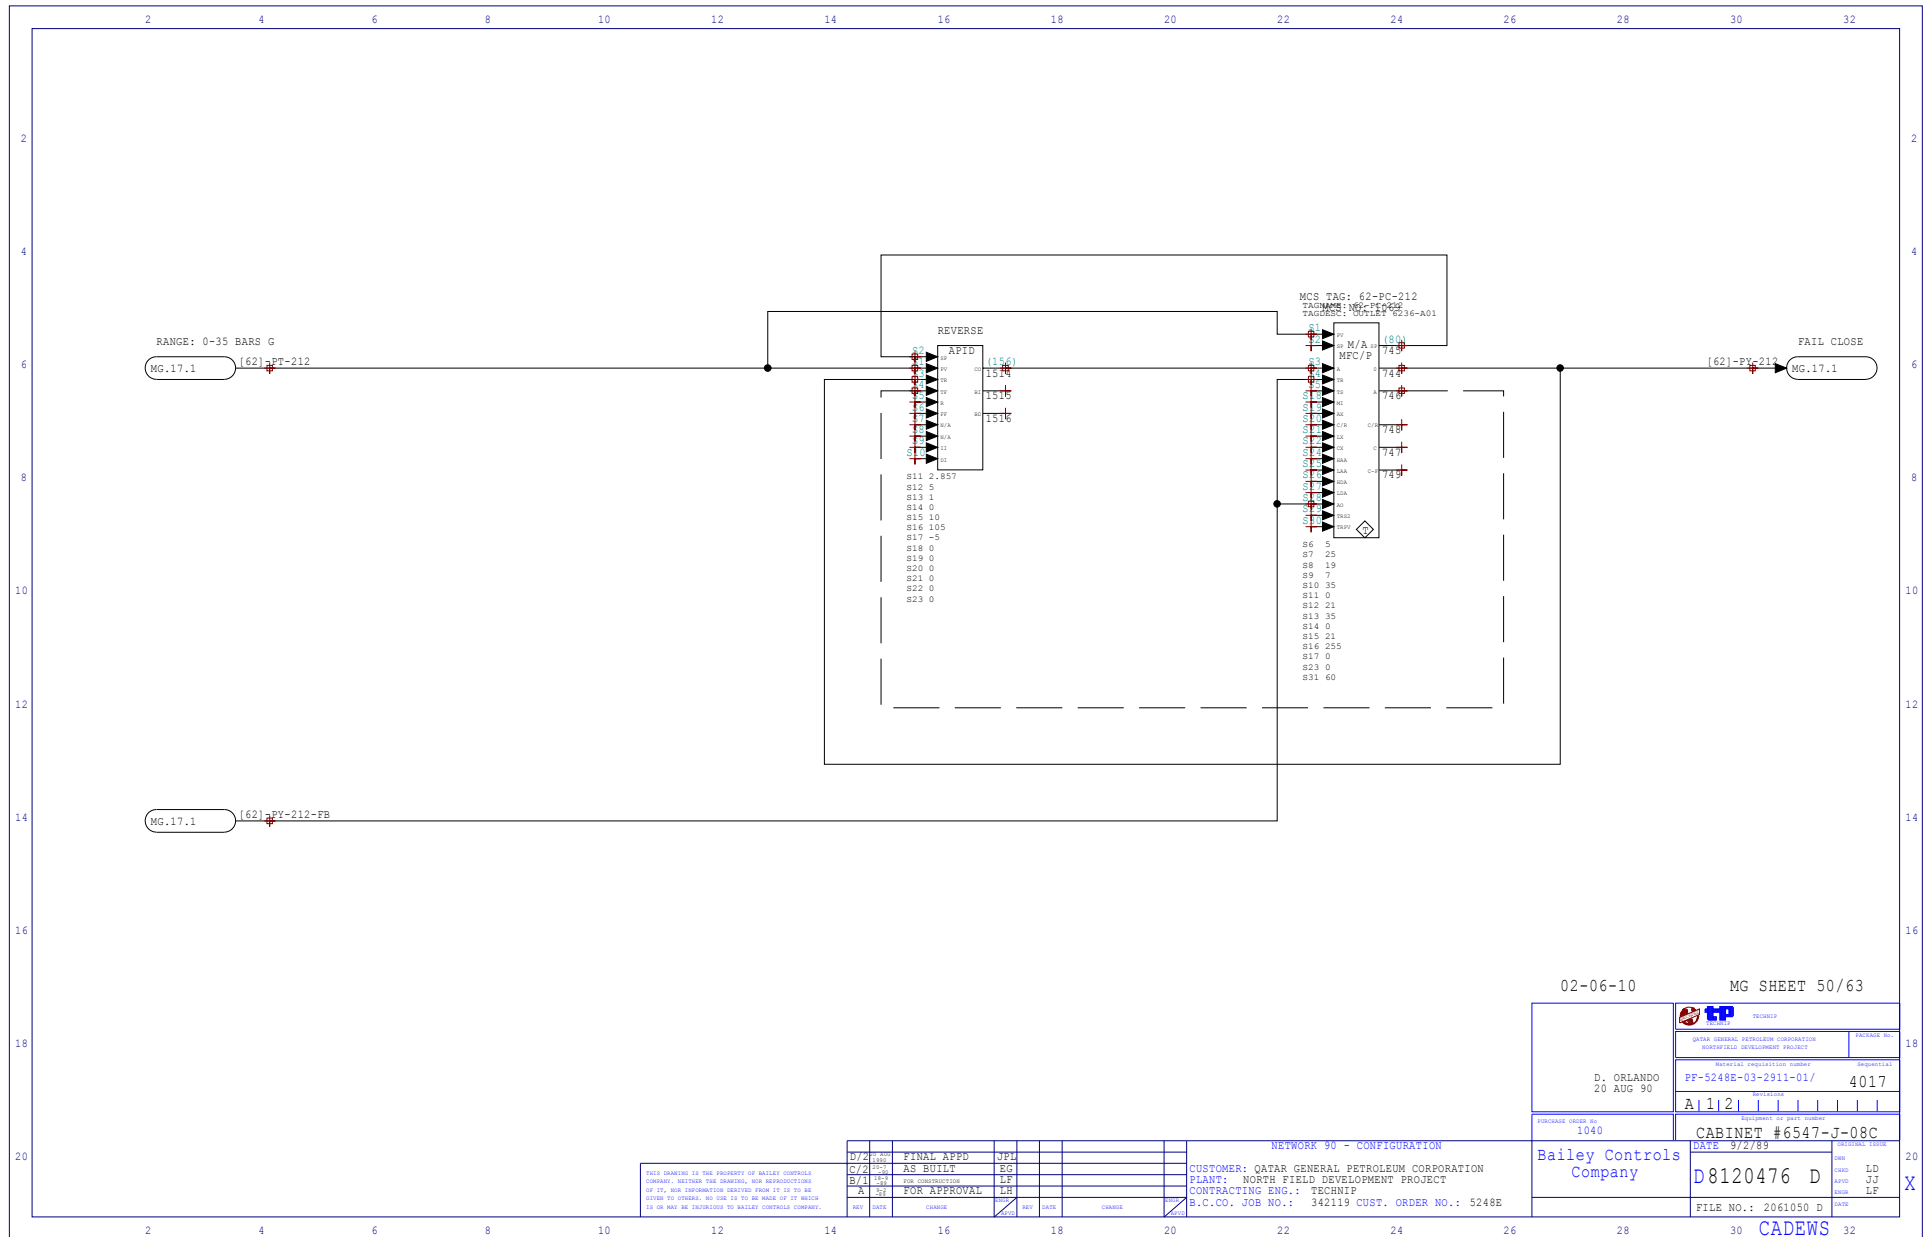


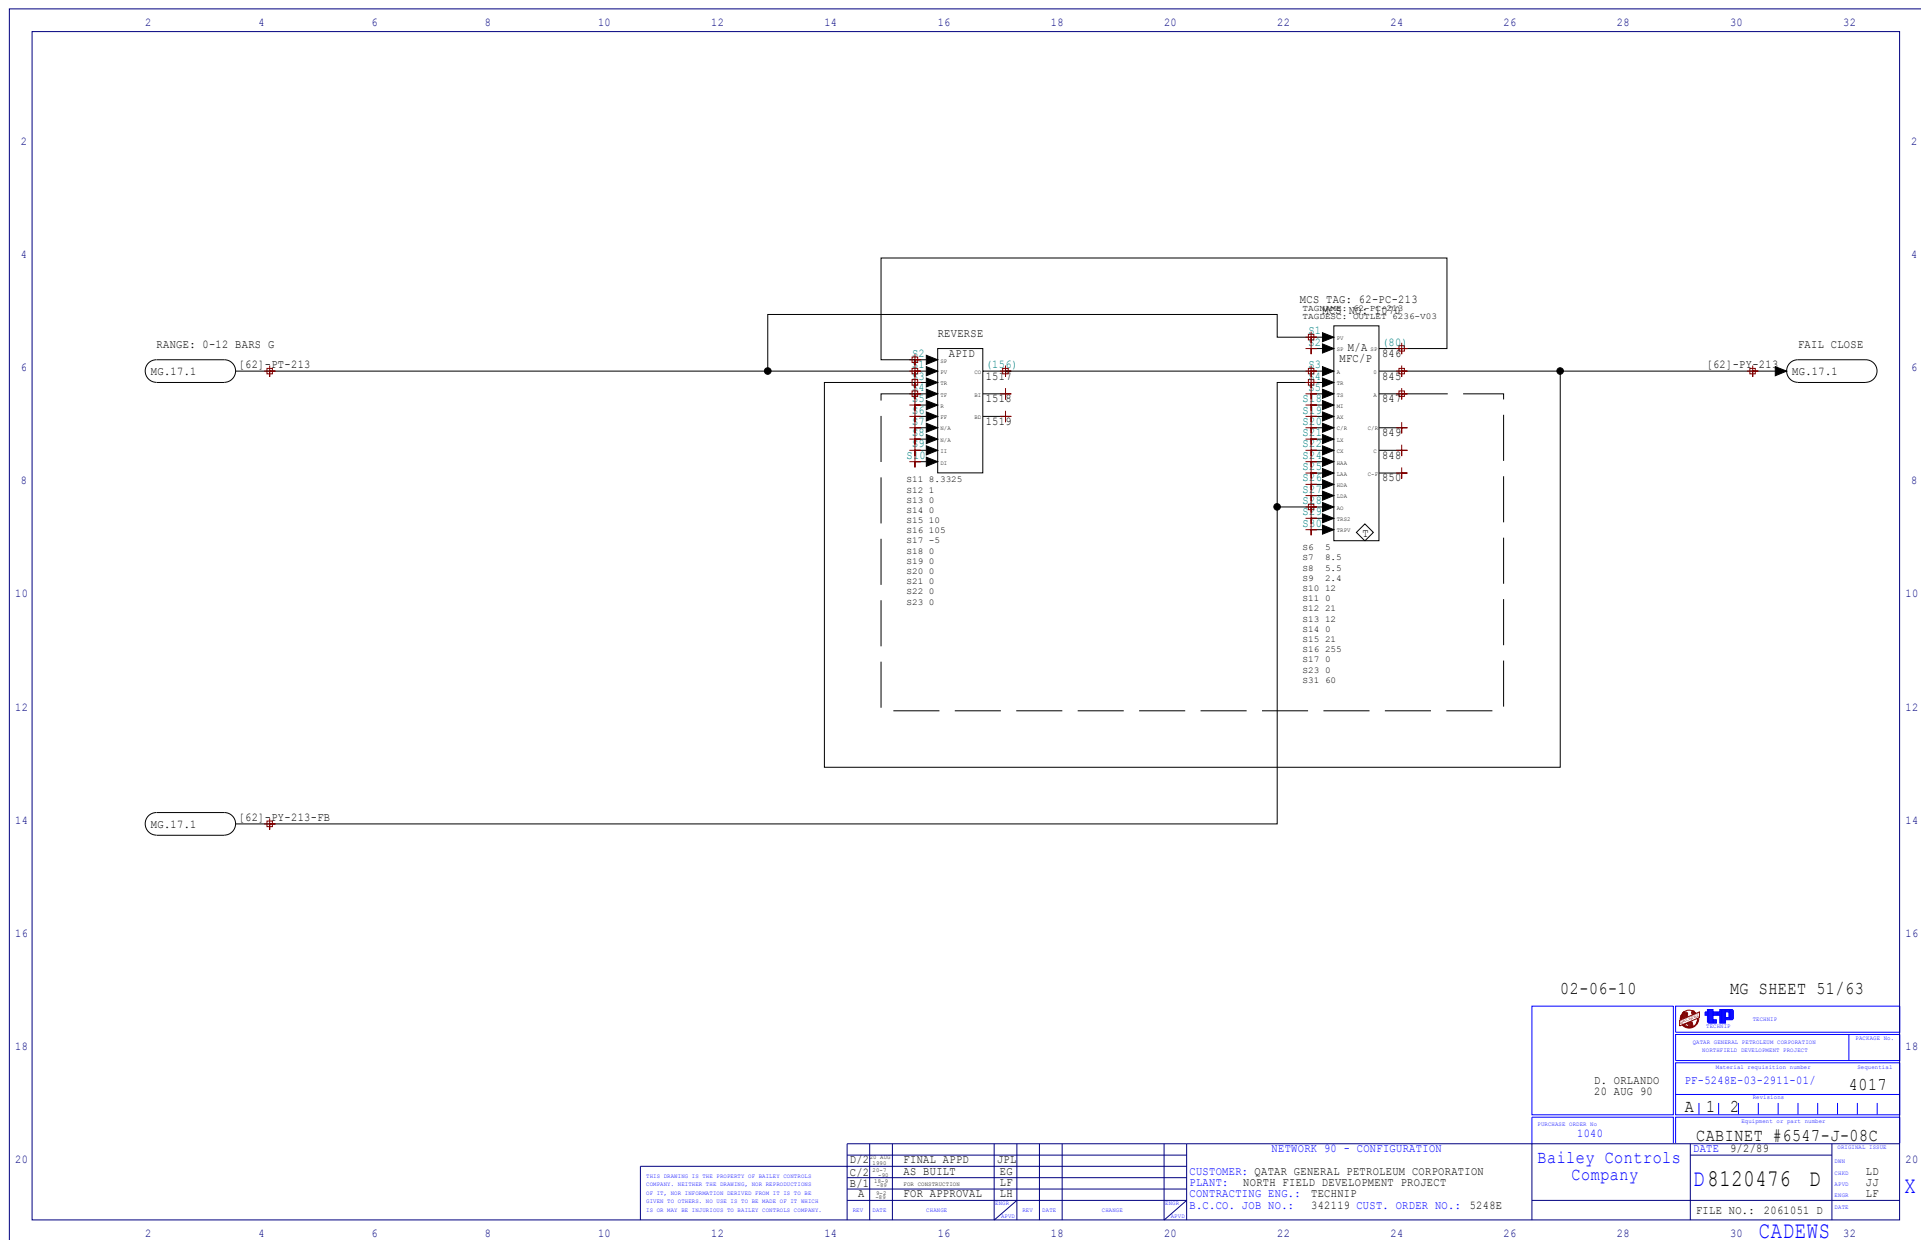


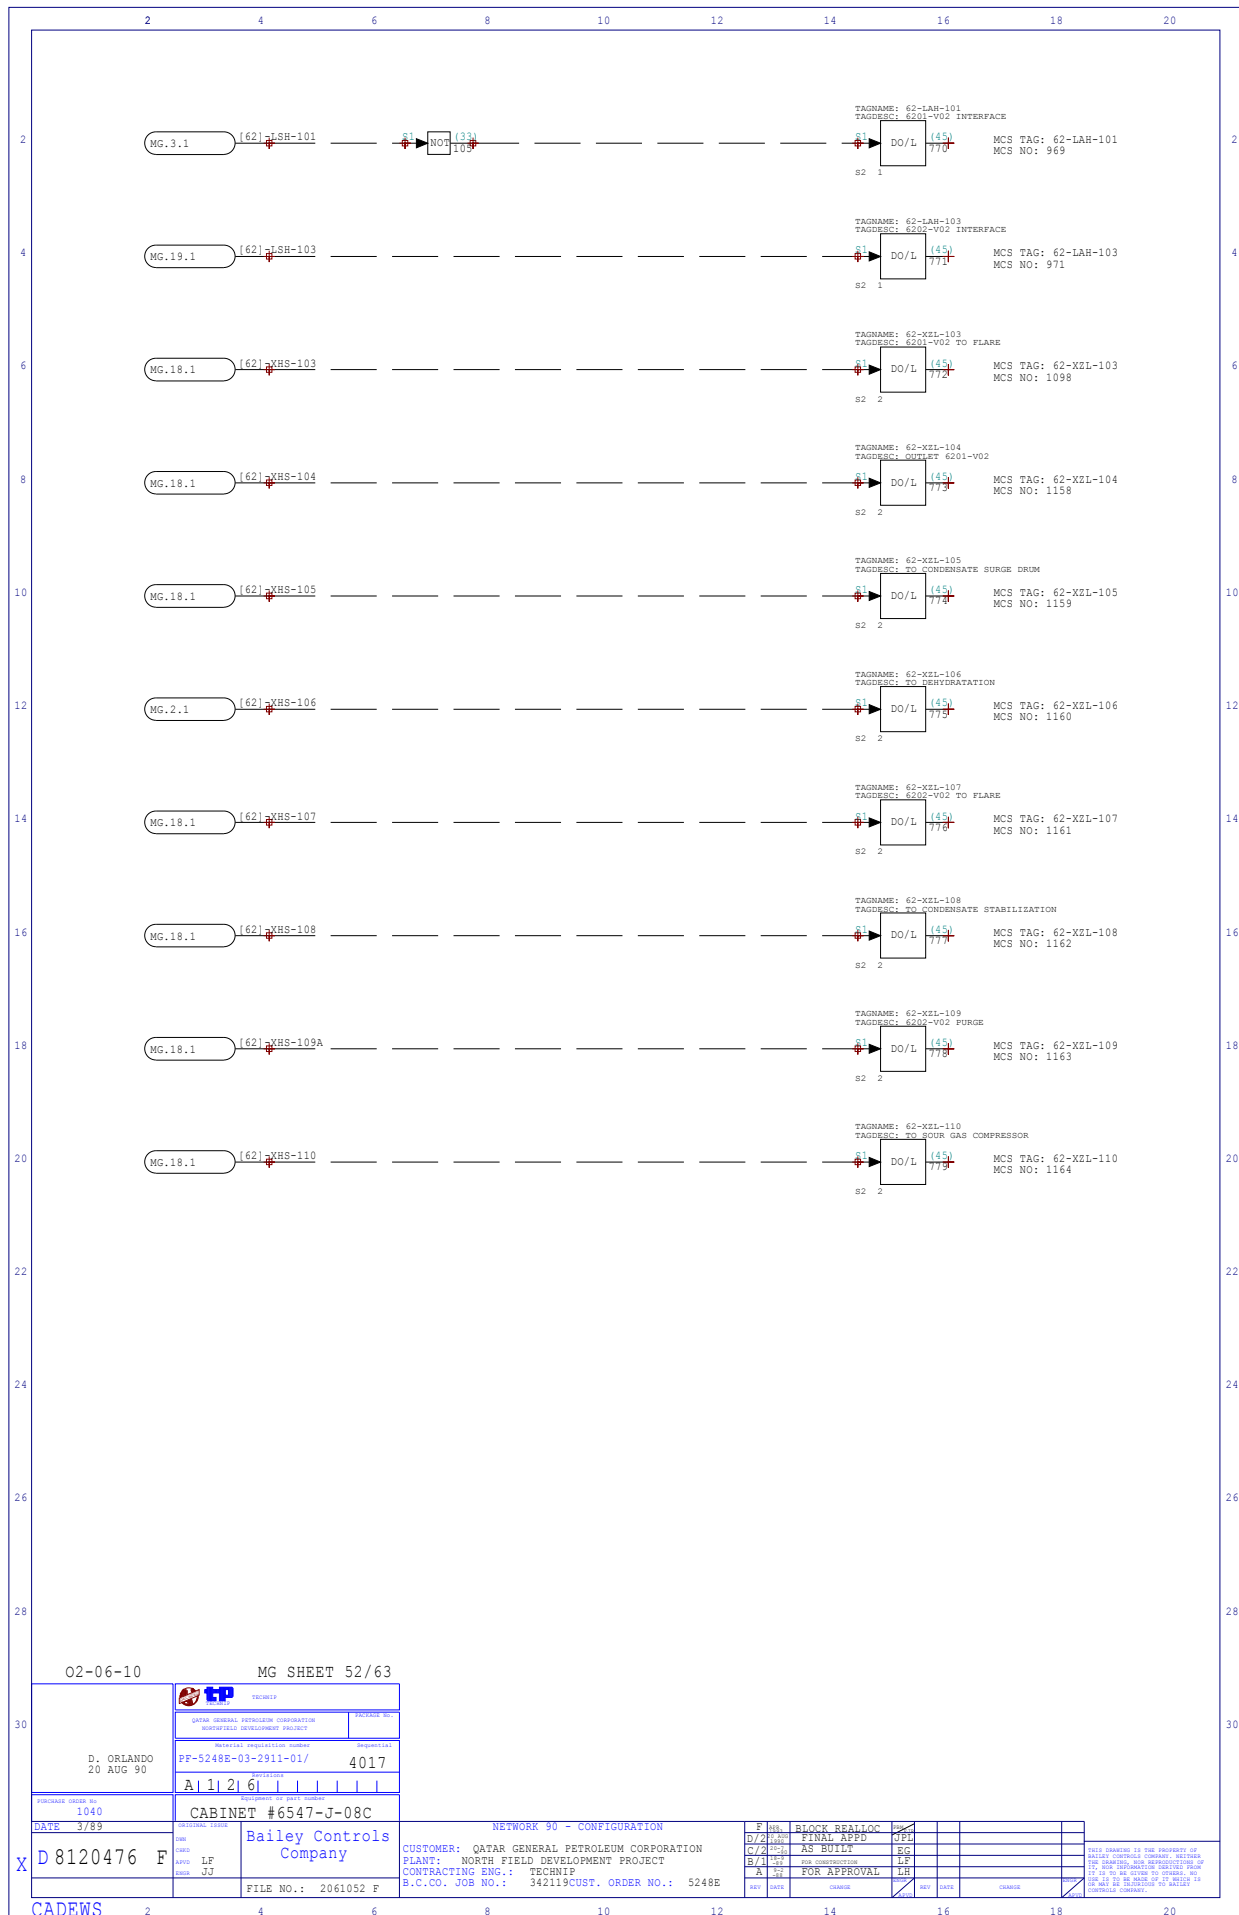


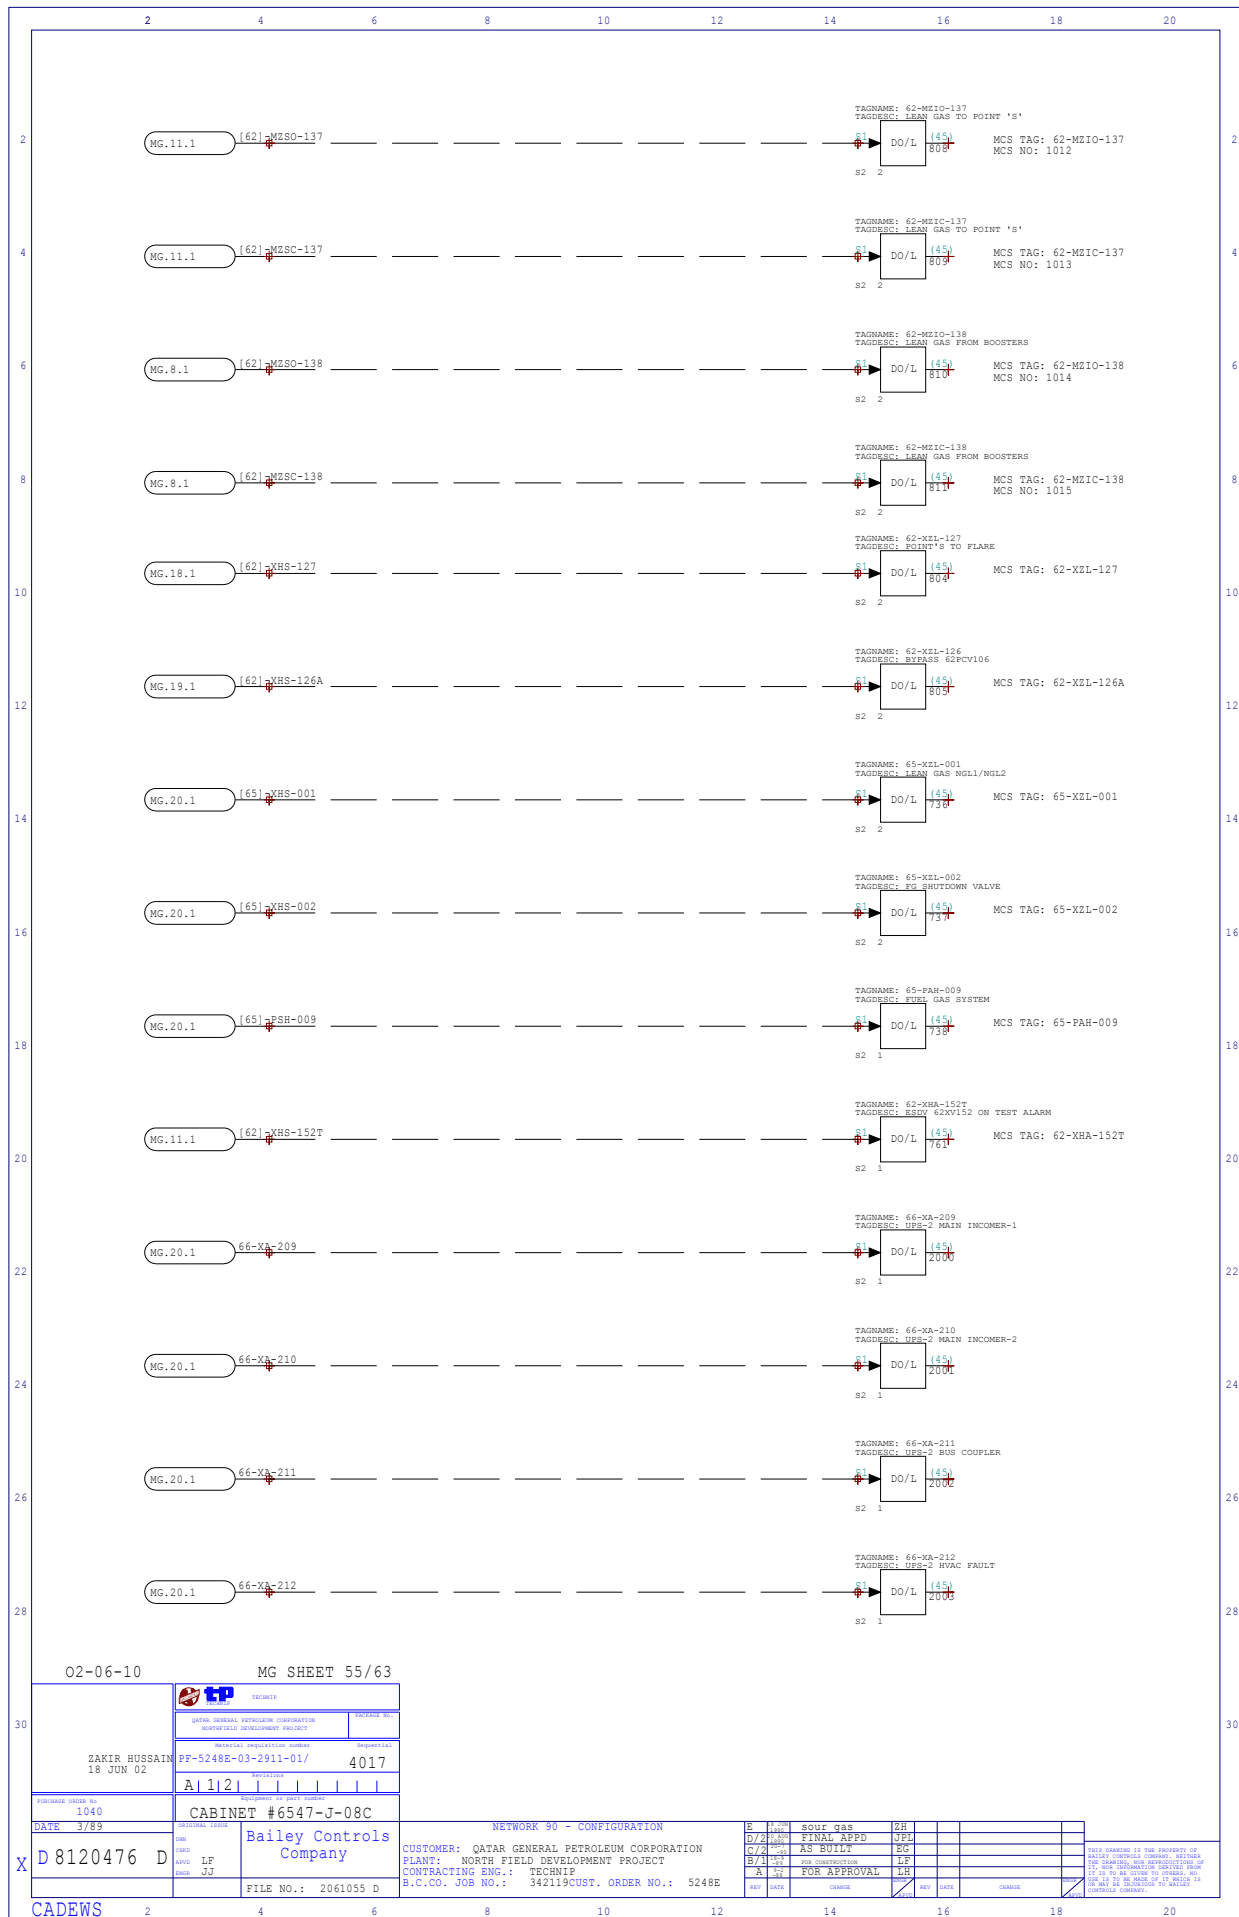


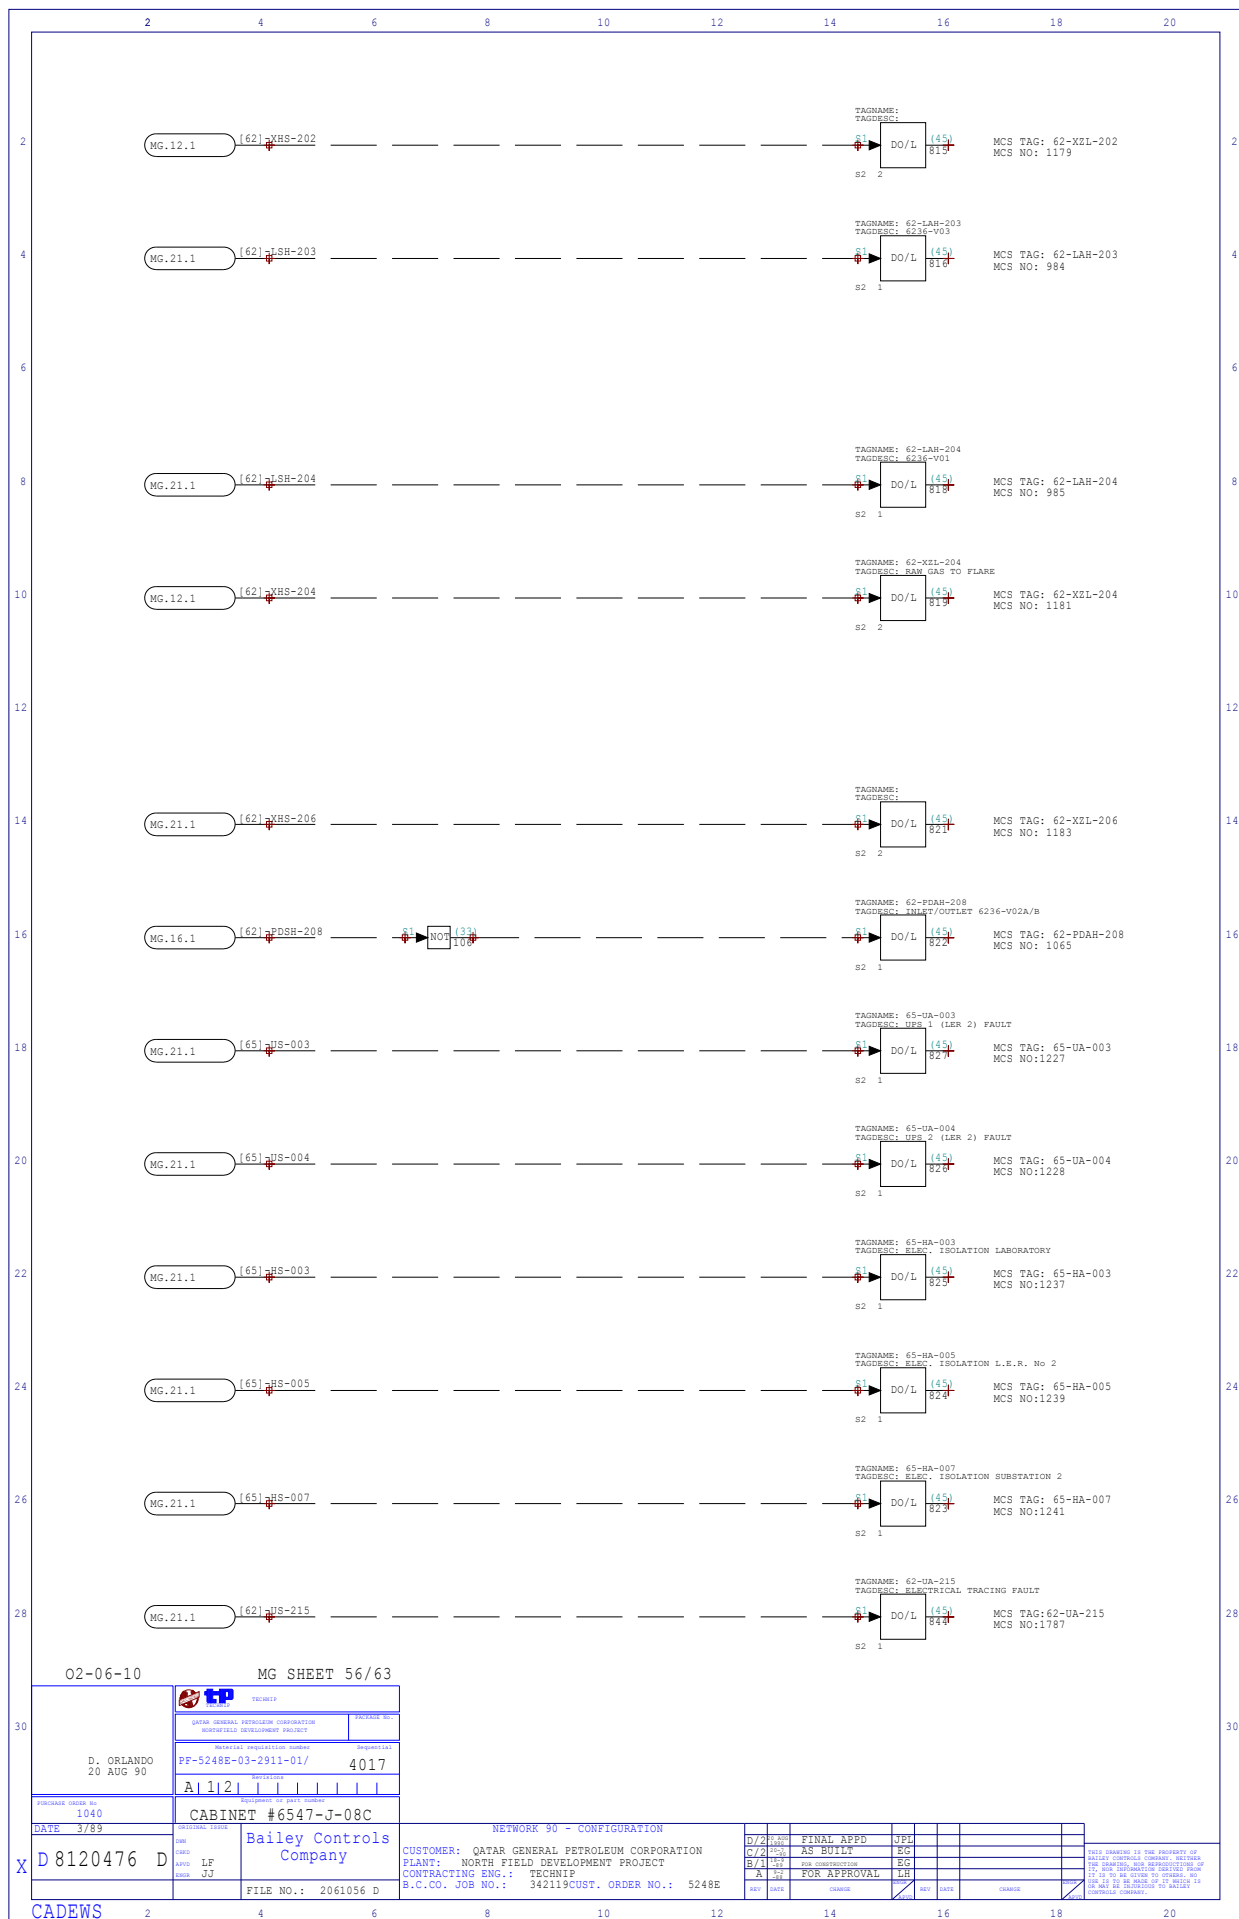


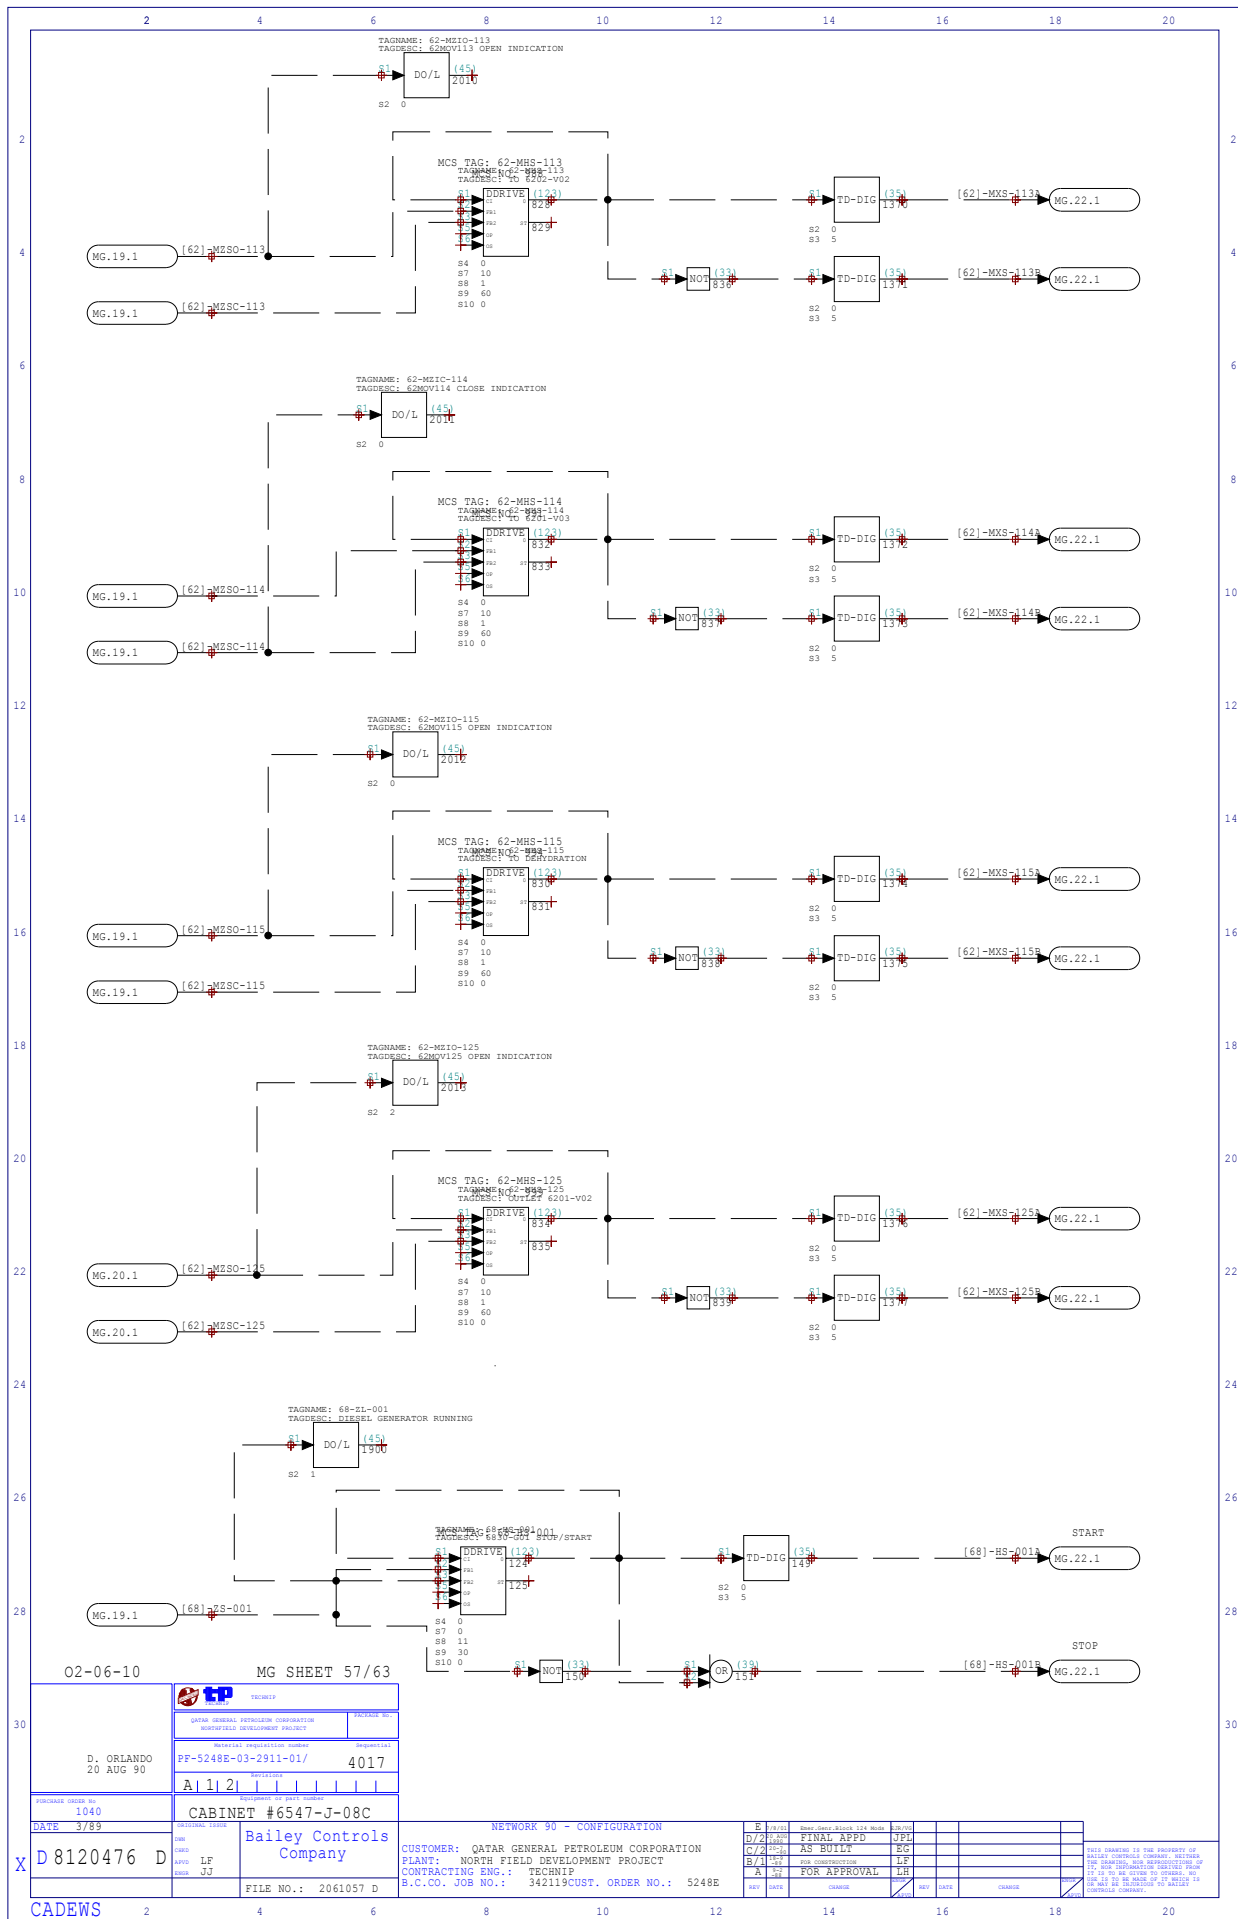


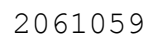


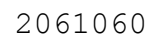


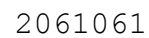

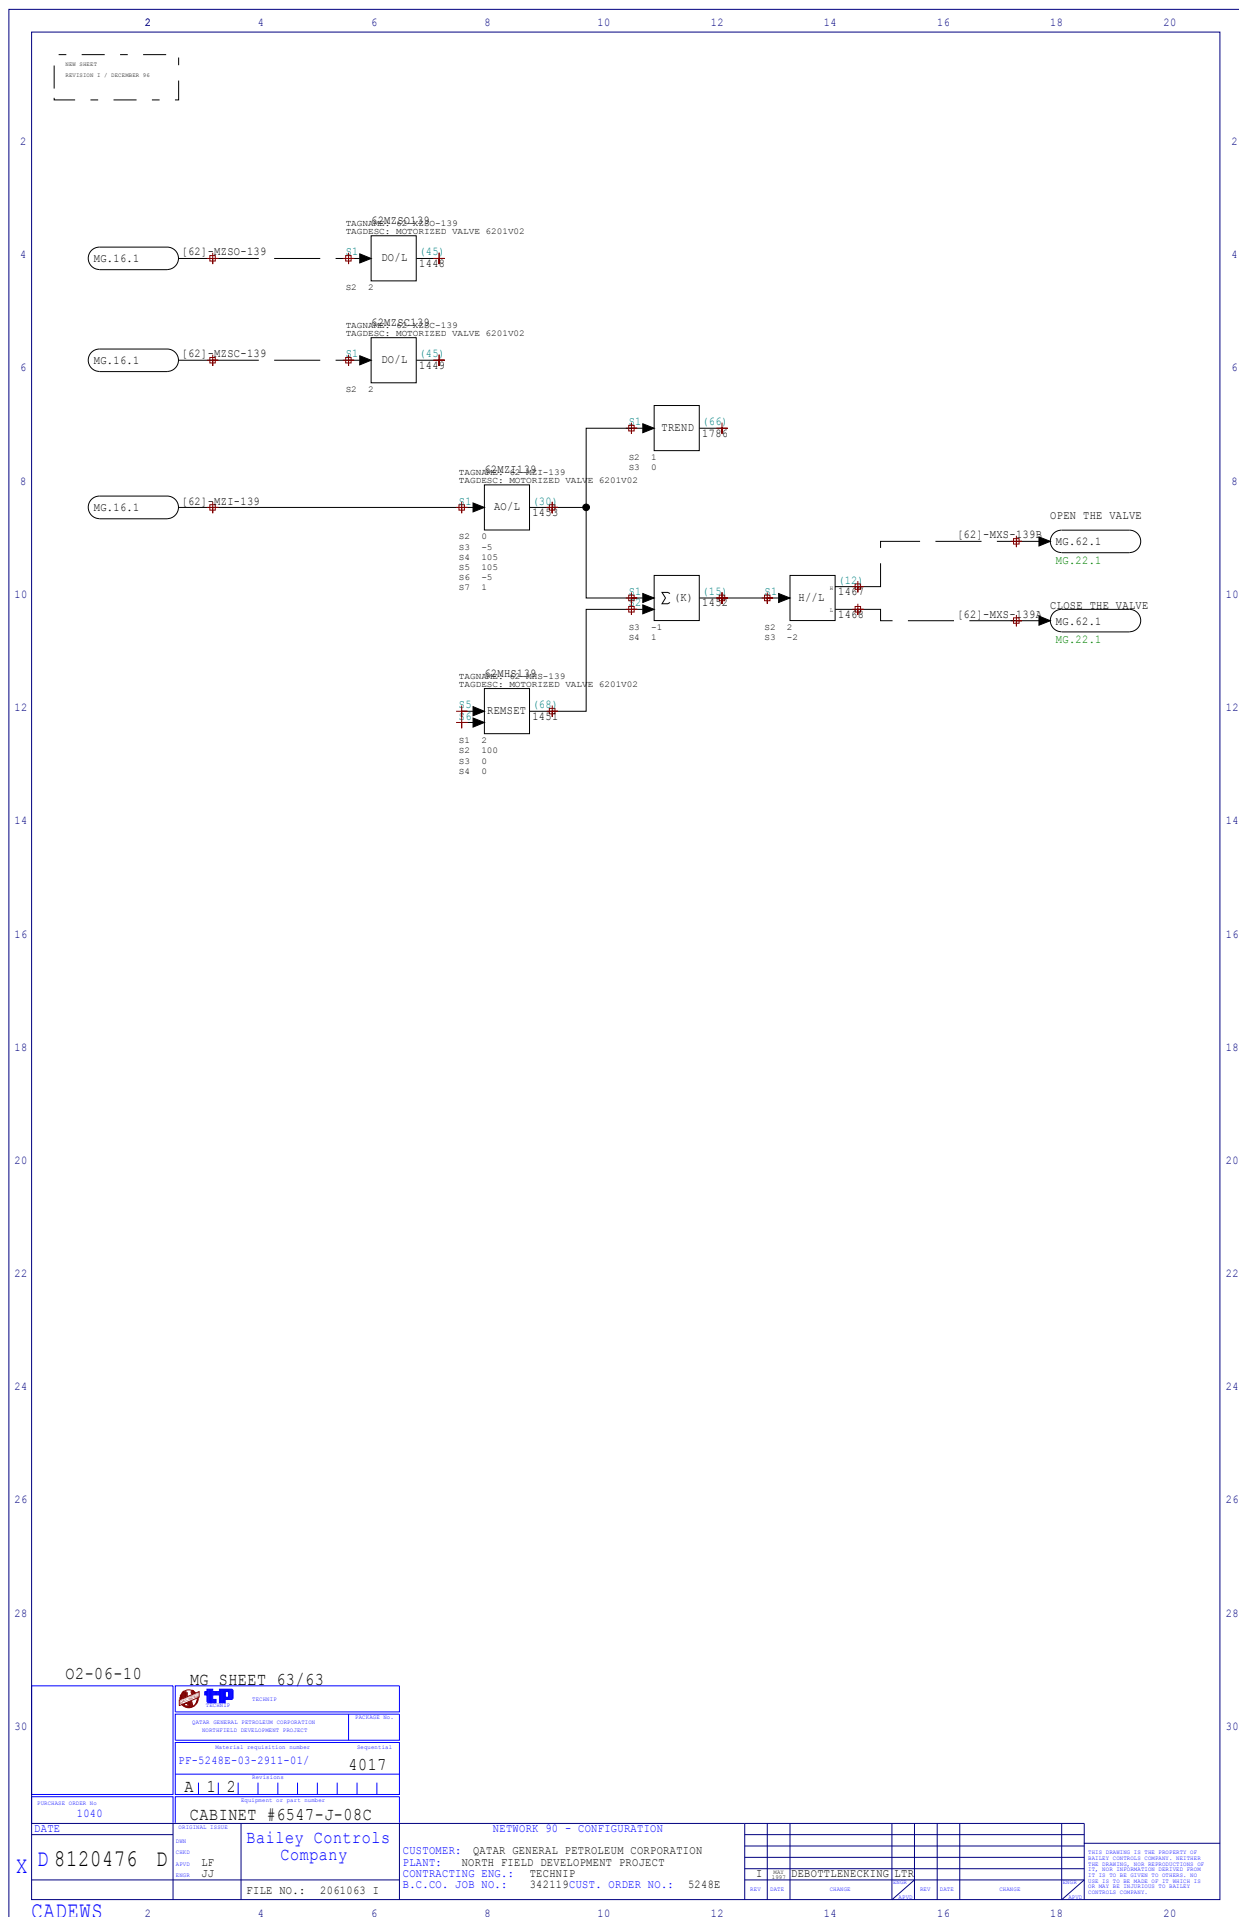

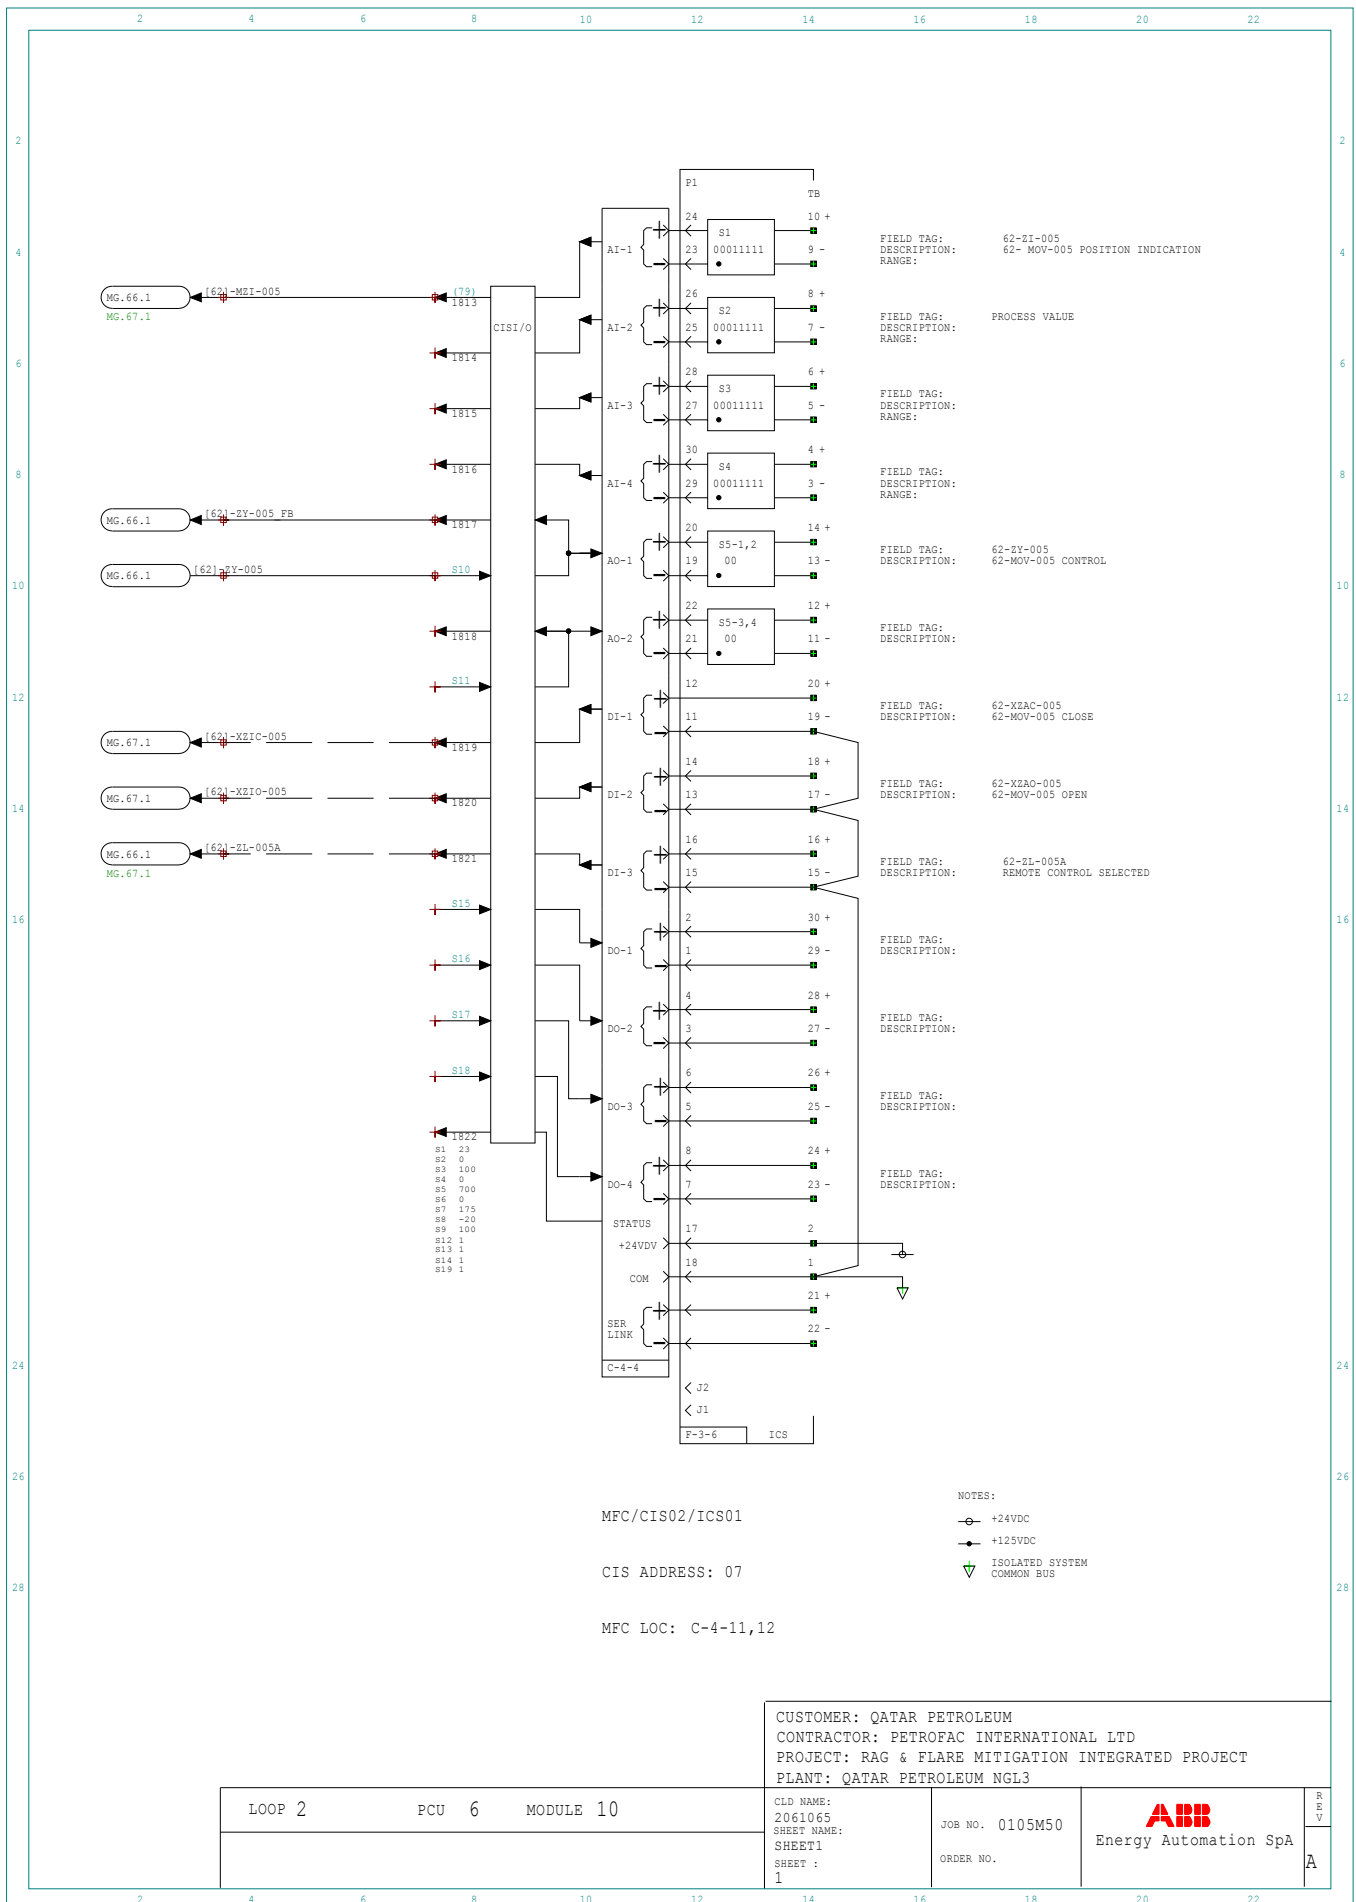

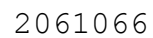

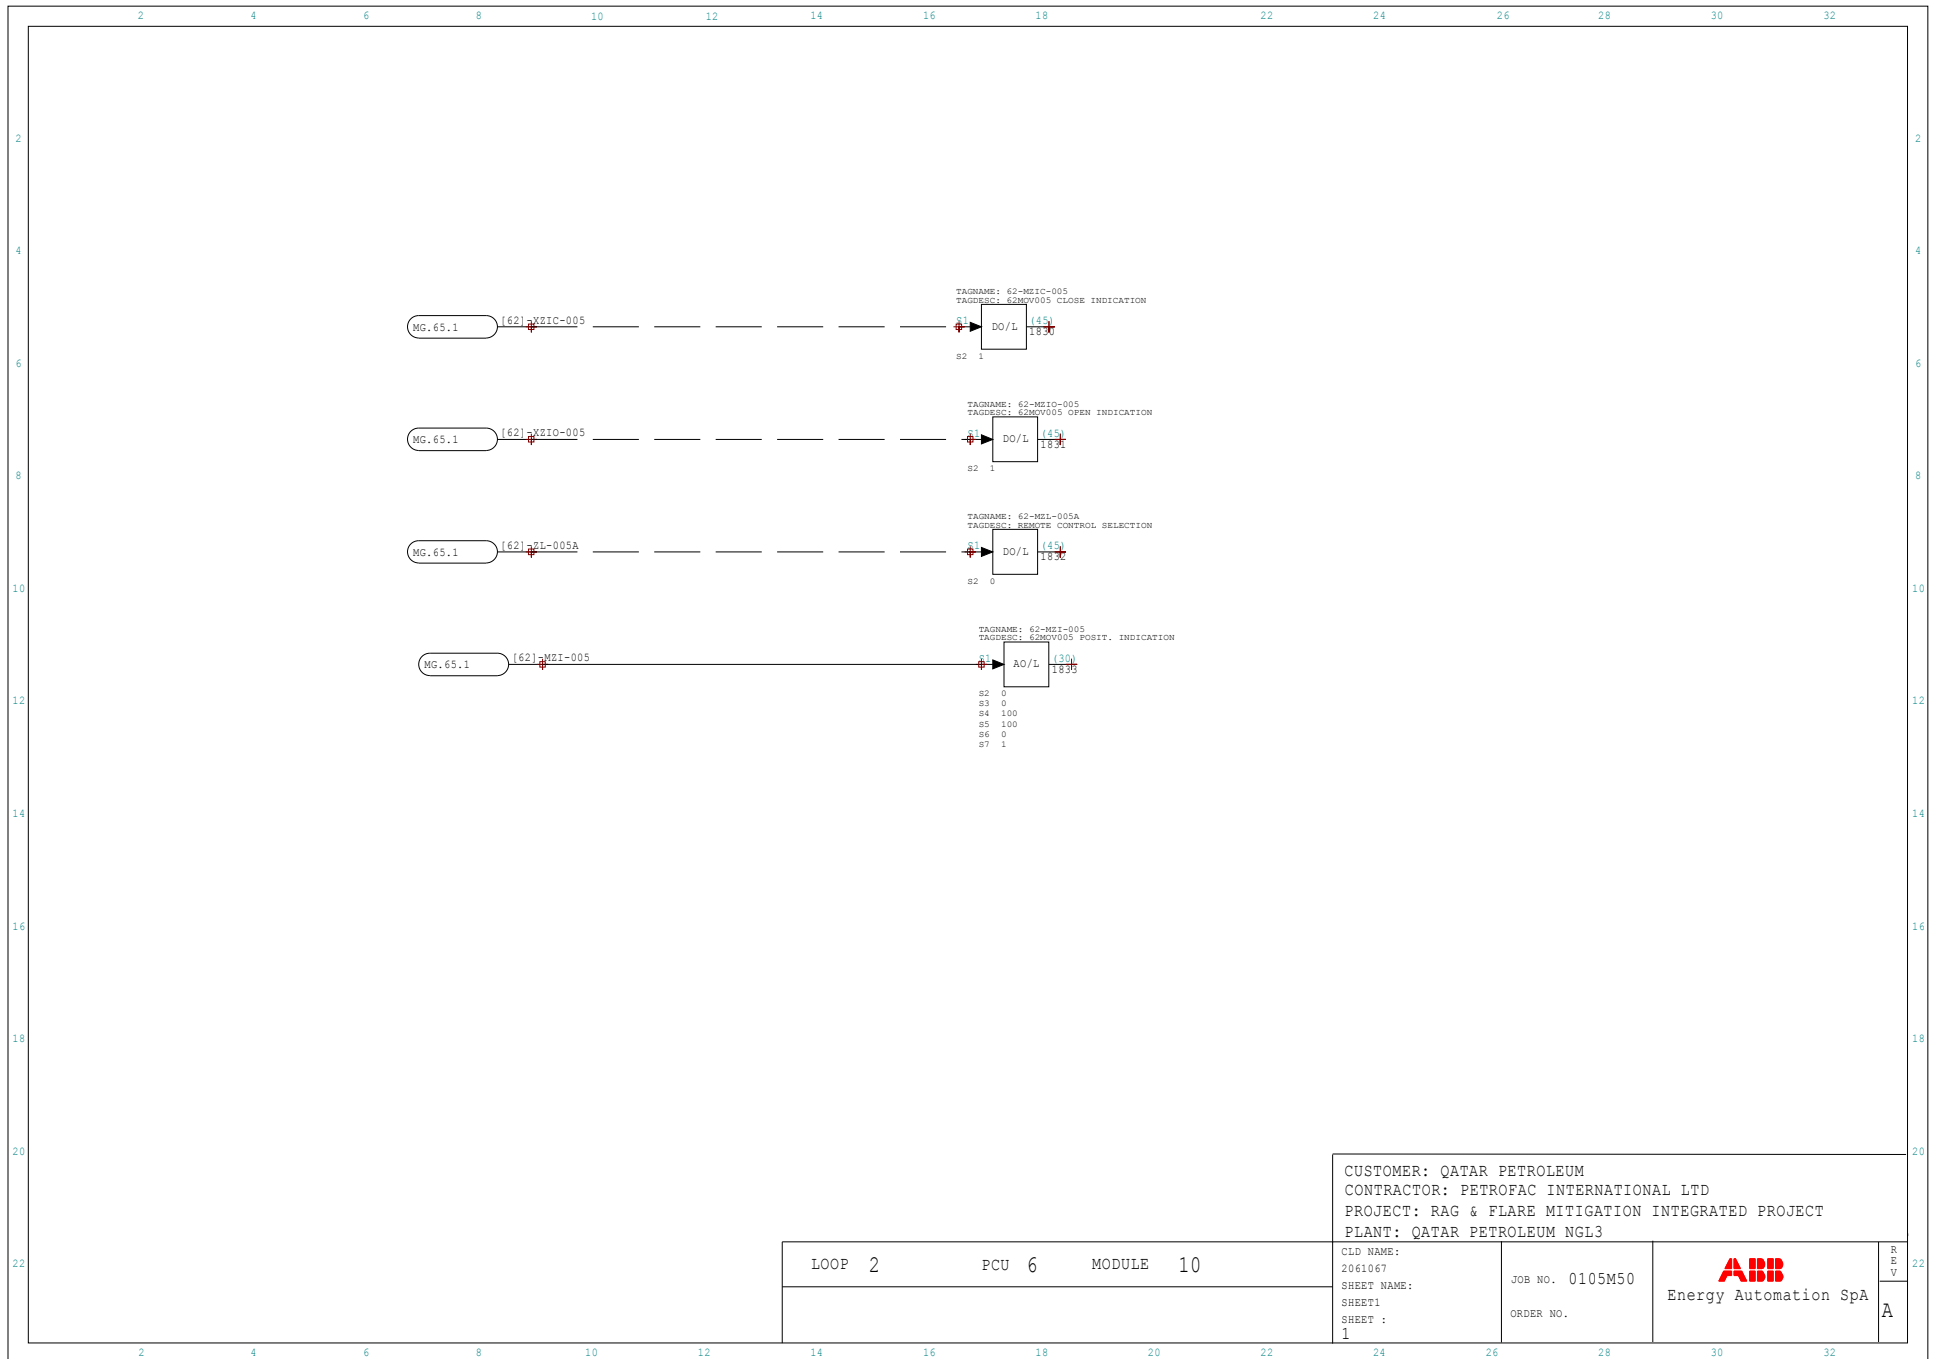


CUSTOMER: QATAR PETROLEUM CONTRACTOR: PETROFAC INTERNATIONAL LTD PROJECT: RAG & FLARE MITIGATION INTEGRATED PROJECT PLANT: QATAR PETROLEUM NGL3			
CLD NAME: 2061067	JOB NO. 0105M50	 Energy Automation SpA	R E V
SHEET NAME: SHEET1 SHEET : 1	ORDER NO.		A

